



## **ADDENDUM #1**

**October 30, 2012**

Re: Harrisburg Area Community College  
Central Administration – Wildwood Conference Center Renovations  
Phase 1 - Demolition  
Solicitation # RFB13-10

From: Eastern PCM, LLC  
Construction Manager – HACC  
645 N. 12<sup>th</sup> Street, Suite 200  
Lemoyne, PA 17043

To: All Planholders

---

This Addendum is hereby made part of the Plans and Project Manual dated October 17, 2012 for the above referenced project. The provisions of this Addendum are intended to supplement the provisions of the Plans and Project Manual and/or supersede them where contradictory thereto.

This Addendum contains changes to the requirements of the Plans and Project Manual. Such changes shall be incorporated into the Plans and Project Manual and shall apply to work with the same meaning and force as if they had been included in the original Plans and Project Manual. Where this Addendum modifies a portion of a paragraph or phrase of the Project Manual, the remaining unmodified portion of the paragraph or phrase shall remain in force.

The conditions and terms of the Plans and Project Manual shall govern work described in this Addendum. Whenever the conditions of work, or the quality or quantity of materials or workmanship are not fully described in this Addendum, the conditions of work etc. included in the Plans and Project Manual for similar items of work shall apply to the work described in this Addendum. If no similar items of work are included in the Plans and Project Manual, the quality of material and workmanship shall be subject to the written acceptance of the Architect.

### **1.1 PRE-BID MEETING MINUTES**

Meeting minutes from the Pre-Bid Meeting held on October 23, 2012 are attached and are a part of this Addendum. In the event of a conflict between the information contained in the Pre-Bid Meeting Notes and the Drawings, Specifications and responses to questions contained in this Addendum, the latter shall take precedence.

### **1.3 CHANGES TO THE DRAWINGS**

A. Cover Sheet: DELETE “P4.2 – Large Scale Penthouse Demolition Plan – Section B – Plumbing.”

- B. Drawing A0.1: REPLACE this drawing in its entirety.
- C. Drawing X2.3: REPLACE this drawing in its entirety.
- D. Drawing X2.4: REPLACE this drawing in its entirety.
- E. Drawing X2.5: REPLACE this drawing in its entirety.
- F. Drawing X2.6: REPLACE this drawing in its entirety.

#### **1.4 ATTACHMENTS**

- A. Drawing A0.1 – Drawing Index and Notes (revised 10/26/12)
- B. Drawing X2.3 – Large Scale First Floor Demolition Plan – Section A (revised 10/26/12)
- C. Drawing X2.4 – Large Scale First Floor Demolition Plan – Section B (revised 10/26/12)
- D. Drawing X2.5 – Large Scale Second Floor Demolition Plan – Section A (revised 10/26/12)
- E. Drawing X2.6 – Large Scale Second Floor Demolition Plan – Section B (revised 10/26/12)
- F. Items Scheduled for Salvage: Identifies what Fixtures, Furniture, and Equipment will be removed prior to the start of demolition and what items the Contractor will be required to remove and turn over to the Owner.
- G. Mumma Hall/Wildwood Conference Center Fire Alarm System Record Drawings, Dated 10/31/11: for reference only.

**END OF ADDENDUM**



Please sign and return this page, via fax, to Eastern PCM, LLC at (717) 233-1666 indicating receipt of this Addendum.

**Central Administration – Wildwood Conference Center Renovations  
Phase 1 – Demolition**

Addendum # \_\_\_\_\_ has been received.

**Company:** \_\_\_\_\_  
Print Company Name

**Received By:** \_\_\_\_\_  
Print Name Signature

**Date:** \_\_\_\_\_

**Please check one:**

- \_\_\_\_\_ We are bidding as a prime contractor
- \_\_\_\_\_ We are not bidding
- \_\_\_\_\_ We are a sub-contractor



1.4 Schedule

Bid Date	Thursday, November 8, 2012 at Penn Center - Room 223, no later than 2:00 PM.
Contract Award	December 5, 2012; subject to Board of Trustees Approval
Construction Start	January 7, 2012; subject to the execution of the contract
Substantial Completion	April 5, 2013

1.5 All questions are to be directed to the office of the Construction Manager in writing via fax or e-mail (attn: Justin Kovaleski): Fax (717) 233-1666, E-mail: [epcm@easternpcm.com](mailto:epcm@easternpcm.com). The last day for questions is Monday, November 5, 2012 at 12:00 PM.

1.6 Addendum #1 will be issued via email on or about Friday, October 26, 2012. Additional Addenda will be issued as required.

1.7 This is a Prevailing Wage Rate Project. Rates can be found in the Project Manual, Specification 00820.

1.8 It is the intention of the Design Team to acquire LEED Silver Certification. Any LEED documentation shall be sent to EPCM and will then be forwarded to Murray Associates Architects. Mr. Kovaleski noted that it will be the responsibility of the Contractor to coordinate all packaging, transportation and documentation of recycled material. A clarification will be made via Addendum stating who will be responsible for the removal of specific materials and FF&E items from the Wildwood Conference Center.

1.9 The Demolition Permit for Phase I: Demolition will be obtained by and paid for by the Owner. All trade specific permits (i.e. Electrical, Plumbing, etc.) are to be obtained and paid for by applicable contractors in accordance with jurisdictional requirements.

1.10 Project Overview

The work will be performed under a single prime contract consisting of the selective demolition of 35,000 SF within the HACC Wildwood Conference Center, including mechanical, plumbing, and electrical demolition. Work includes requirements for recycling, salvaging and reuse of demolition waste and existing materials and equipment as specified. Specification Section 01524 – Construction Waste Management includes specific administrative and procedural requirements for this work.

Demolition work pertaining to mechanical, electrical and plumbing shall include the following: disconnecting utilities (gas, electric, water, telecom) by Contractor, maintaining select heat pumps for temporary heat and removing all toilets and fixtures.

1.11 All temporary construction entrance, temporary dust barriers and partitions, and temporary signage shall be in accordance with the Bid Documents or be provided as required.

1.12 All occupied areas must be left in existing condition.



- 1.13 Designated Contractor parking shall be established prior to the start of the project.
- 1.14 It was inquired if the Contractors are required to hire minority or women owned businesses. Mr. Kovaleski clarified that HACC requires the MBE/WBE Utilization Form to be filled out and for Contractors to solicit minority or women owned businesses but that those businesses are not required to be utilized.  
**Post Meeting Note:** HACC encourages the use of minority and women owned businesses as stated in the Advertisement for Bid.
- 1.15 It was inquired if there is a weight limit on the bridge connecting the site of the Wildwood Conference Center and the commuter parking lot. Mr. Chonoski noted that there is a weight limit. He also noted if the concern is delivery of heavy machinery that there is a service road leading to the Wildwood Conference Center from Alumni Drive that can handle such deliveries.
- 1.16 It was noted that the electrical room in the penthouse will remain through the demolition phase.
- 1.17 Contractors were advised that the overall project will be executed in three phases; Phase 1 – Demolition, Phase 2 – Roofing/Fenestration, and Phase 3 – Renovation. This bid is for phase 1 only.
- 1.18 A site tour was conducted. The conference room adjacent to the toilet rooms on the first floor, the kitchen on the second floor and one of the Seminar areas were occupied and could not be inspected during the site tour.
- 1.19 It was inquired whether an asbestos survey had been conducted for the building. It is not expected that hazardous materials will be encountered during the work.
- 1.20 Refer to the plans and specifications for any specific requirements related to demolition of IT cabling.
- 1.21 Mr. Chonoski addressed some known items to be removed by the Contractor vs. the Owner during the walk-thru. A complete list of these items will be provided via Addendum.
- 1.22 Mr. Chonoski showed Bidders where access to Hall Tech will be adjacent to the construction zone. He stressed the importance of safety measures within this area.
- 1.23 Mr. Chonoski noted that heavy equipment/machinery shall be delivered before 7:00 am.
- 1.24 Mr. Chonoski showed Bidders accessibility for delivery of equipment via a loading dock that is adjacent to one of the Seminar Suites.
- 1.25 Mr. Chonoski noted that anything that is to remain must be protected throughout the demolition phase.
- 1.26 The kitchen on the second floor was occupied and was not inspected. Mr. Chonoski did show Bidders the service elevator within the second floor kitchen area.

HACC, Central Pennsylvania's Community College  
Central Administration – Wildwood Conference Center Renovations  
Phase I – Demolition  
Pre-Bid Meeting Minutes  
October 23, 2012  
Page 4

1.27 Additional site visits should be coordinated through Eastern PCM, LLC.

---

Respectfully Submitted,  
Sarah E. Centini, Eastern PCM, LLC

The above summations are the interpretation of the author as to the items discussed and the decisions reached. Corrections or additions to these minutes are to be made in writing and sent to the attention of the Author no later than 5 days after receipt; otherwise, these minutes will stand as written.

cc: All Attendees




ARCHITECTURAL DRAWING LIST

- COVER SHEET
- AO.1 DRAWING INDEX AND NOTES
- X2.1 FIRST FLOOR PLAN - COMPOSITE - DEMOLITION
- X2.2 SECOND FLOOR PLAN - COMPOSITE - DEMOLITION
- X2.3 LARGE SCALE FIRST FLOOR DEMOLITION PLAN - SECTION A
- X2.4 LARGE SCALE FIRST FLOOR DEMOLITION PLAN - SECTION B
- X2.5 LARGE SCALE SECOND FLOOR DEMOLITION PLAN - SECTION A
- X2.6 LARGE SCALE SECOND FLOOR DEMOLITION PLAN - SECTION B

GENERAL NOTES - DEMOLITION

1. IT SHALL BE THE CONTRACTOR'S RESPONSIBILITY TO EXAMINE THE EXISTING BUILDING DURING THE COURSE OF DEMOLITION AND IMMEDIATELY ADVISE THE ARCHITECT AND OWNER'S REPRESENTATIVE OF ANY AREAS WHERE THE STRUCTURE EXHIBITS SIGNS OF DISTRESS OR FAILURE.
2. IT SHALL BE THE CONTRACTOR'S RESPONSIBILITY TO VERIFY THE LOCATION OF ALL EXISTING UTILITIES IN THE IMMEDIATE VICINITY OF DEMOLITION ACTIVITIES SO AS TO PREVENT DAMAGE TO THEM. SHOULD ANY DAMAGE TO SUCH UTILITIES OCCUR, THE CONTRACTOR SHALL BE REQUIRED TO REPAIR SUCH DAMAGE AT THEIR OWN EXPENSE TO THE SATISFACTION OF THE OWNER.
3. REMOVE AND SALVAGE: ITEMS TO BE REMOVED AND SALVAGED REMAIN THE OWNER'S PROPERTY. GENERAL CONTRACTOR TO REMOVE, CLEAN AND PACK OR CRATE ITEMS TO PROTECT AGAINST DAMAGE. IDENTIFY CONTENTS OF CONTAINERS AND DELIVER TO OWNER'S DESIGNATED STORAGE AREA ON CAMPUS.
4. REMOVE AND INSTALL: REMOVE ITEMS INDICATED: CLEAN, SERVICE AND OTHERWISE PREPARE THEM FOR REUSE, STORE AND PROTECT AGAINST DAMAGE.
5. EXISTING TO REMAIN: PROTECT CONSTRUCTION INDICATED TO REMAIN AGAINST DAMAGE AND SOILING DURING SELECTIVE DEMOLITION. WHEN PERMITTED BY THE ARCHITECT, ITEMS MAY BE REMOVED TO A SUITABLE, PROTECTED STORAGE LOCATION DURING SELECTIVE DEMOLITION AND THEN CLEANED, REFINISHED AND REINSTALLED IN THEIR ORIGINAL LOCATIONS.
6. RIGHT OF FIRST REFUSAL: THE OWNER HAS FIRST RIGHT OF REFUSAL OF ALL MATERIALS AND BUILDING COMPONENTS. NO ITEMS SHALL BE REMOVED FROM THE SITE WITHOUT WRITTEN PERMISSION FROM THE ARCHITECT, OWNER'S REPRESENTATIVE OR OWNER.
7. OWNER SHALL REMOVE ALL LOOSE SUPPLIES, FURNITURE, FURNISHINGS AND ARE NOT LIMITED TO THE FOLLOWING: EQUIPMENT, RACKS, SHELVING, OVERHEAD PROJECTORS, FURNITURE SYSTEMS, CHAIRS, FILE CABINETS AND DEFIBRILLATORS PRIOR TO START OF DEMOLITION.
8. REFER TO GENERAL DEMOLITION NOTES FOR CUTTING, PATCHING AND MAINTAINING OF THE STRUCTURAL INTEGRITY OF REMAINING BUILDING ELEMENTS.
9. COMPLY WITH GOVERNING REGULATIONS PERTAINING TO ENVIRONMENTAL PROTECTION FOR POLLUTION CONTROL, AND HAZARDOUS/TOXIC MATERIALS. THE ARCHITECT SHALL HAVE NO RESPONSIBILITY FOR THE DISCOVERY OR PRESENCE OF POLYCHLORINATED BIPHENYLS (PCBS) OR ANY OTHER TOXIC SUBSTANCES.
10. FOLLOW ALL LEED DOCUMENTATION REQUIREMENTS AS INDICATED IN THE SPECIFICATIONS.
11. EXISTING STATUE AND BENCH TO REMAIN. DEMOLITION CONTRACTOR SHALL BE RESPONSIBLE TO ERECT TEMPORARY ENCLOSURE TO ELIMINATE DAMAGE. ANY DAMAGE TO BENCH OR STATUE SHALL BE THE DEMOLITION CONTRACTOR'S RESPONSIBILITY.
12. ALL SOLID CHERRY RAISED PANEL DOORS, WANSICOAT, WALL PANELING, CHAIR RAIL AND BASE SHALL BE REMOVED, PALLETIZED AND DELIVERED TO OWNER'S WAREHOUSE ON CAMPUS.
13. DEMOLITION CONTRACTORS ARE RESPONSIBLE FOR COORDINATING, PROCESSING, REMOVAL AND PALLETIZING, SHIPPING COSTS RELATING TO THE RECYCLING, RE-ENTRY PROGRAM WITH INTERFACE CARPETS. CONTACT BARS MONCRIEF (717-475-9921) TO COMPLETE DOCUMENTATION AND SCHEDULE PICK UP ON CARPET MATERIALS. TILE RECYCLING PROGRAMING BY GARDEN STATE TILE. CONTACT LIZ MATTERS (717-285-2643) TO COMPLETE DOCUMENTATION AND SCHEDULE PICK UP ON PORCELAIN TILE MATERIALS.
14. DEMOLITION CONTRACTORS ARE RESPONSIBLE FOR COORDINATING, PROCESSING, REMOVAL AND PALLETIZING, SHIPPING COSTS RELATING TO THE RECYCLING OF CEILING TILE, GRID AND HANGING WIRE. COORDINATE, CONTACT AND PICK UP WITH OWNER.
15. PROVIDE PROTECTION AS REQUIRED FOR STAINLESS STEEL ELEVATOR DOORS AND FRAME.
16. PROVIDE COMPACTED CLEAN STONE THAT SHALL BE FLUSH WITH THE EXISTING GRADE IN THE AREA OF THE EXCAVATION OF THE FOOTINGS AND FOUNDATIONS OF THE SHED. PATCH AND REPAIR THE EXISTING ASPHALT AFTER REMOVAL OF ITEMS.
17. DEMOLITION CONTRACTOR SHALL PROTECT EXISTING PAINTED GYPSUM WALL, HANDRAIL, RUBBER TREADS & LANDINGS, PAINTED STRINGERS & RISERS AND METAL GAP AS REQUIRED THROUGH OUT THE ENTIRE PHASE.
18. DEMOLITION CONTRACTOR SHALL PROTECT EXISTING HANDRAIL, PICKET SYSTEM, RUBBER TREADS & LANDINGS AND PAINTED STRINGERS & RISERS AS REQUIRED THROUGH OUT THE ENTIRE PHASE.
19. DEMOLITION CONTRACTOR SHALL PROTECT EXISTING GLASS RAILING, METAL GAP, WOOD PANELING, EXPOSED MASONRY AND WOODEN HANDRAIL AS REQUIRED THROUGH OUT THE ENTIRE PHASE.
20. REMOVAL OF ROLLED GOOD CARPETS AND CARPET TILES SHALL INCLUDE ALL ADHESIVES, TRANSITION STRIPS, INSTALLATION ACCESSORIES AND THRESHOLDS.
21. DEMOLITION OF THE PORCELAIN TILE SHALL ALSO INCLUDE ALL GROUT AND SETTING MATERIALS. ALL MATERIALS SHALL BE REMOVED DOWN TO THE EXISTING CONCRETE SLAB.
22. DEMOLITION CONTRACTOR IS RESPONSIBLE FOR PROTECTING ALL WOOD PANELING AS REQUIRED THROUGH OUT ENTIRE PHASE.

GENERAL DEMOLITION LEGEND

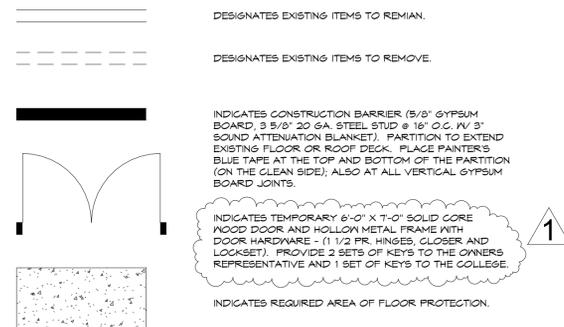

DEMOLITION KEYNOTES	
NUMBER	DESCRIPTION
1	REMOVE EXISTING FOLDING PARTITION TRACK SYSTEM AND BULKHEAD.
2	REMOVE EXISTING DOOR, FRAME AND HARDWARE; SEE GENERAL NOTE #12.
3	REMOVE EXISTING PARTITION IN ITS ENTIRETY.
4	REMOVE EXISTING CHAIR RAILS.
5	REMOVE PORTION OF PARTITION.
6	REMOVE EXISTING FOOD SERVICE EQUIPMENT; BY OWNER.
7	REMOVE EXISTING FLOORING. SEE GENERAL NOTE #13.
8	REMOVE EXISTING CEILING SYSTEM. SEE GENERAL NOTE #14, 20 AND 21.
9	REMOVE EXISTING PLUMBING FIXTURES; SEE PLUMBING DRAWINGS.
10	REMOVE EXISTING TOILET PARTITIONS.
11	REMOVE EXISTING TOILET ACCESSORIES. TURN OVER TO OWNER.
12	REMOVE EXISTING DOOR; SEE GENERAL NOTE #12.
13	REMOVE EXISTING COLUMN ENCLOSURE.
14	REMOVE EXISTING FURNITURE, ARTWORK AND PLANTERS; BY OWNER.
15	REMOVE EXISTING FIRE EXTINGUISHER CABINET. TURN OVER TO OWNER.
16	REMOVE EXISTING FRAME.
17	REMOVE EXISTING COAT RACK AND SHELF.
18	REMOVE EXISTING BULKHEAD ABOVE.
19	REMOVE EXISTING CASEWORK.
20	REMOVE EXISTING WINDOW TREATMENTS & HARDWARE.
21	REMOVE EXISTING WALK-OFF MATS.
22	REMOVE EXISTING OVERHEAD COILING DOOR, BULKHEAD AND ALL ASSOCIATED HARDWARE/SUPPORTS.
23	REMOVE EXISTING CORNER GUARDS.
24	REMOVE EXISTING BASE.
25	REMOVE EXISTING SOUND/PAK PANELS / TRACKSTRIP / WOOD CHAIR RAIL / PLYWOOD PANELING / WOOD BASE SYSTEM; SEE GENERAL NOTE #12.
26	REMOVE EXISTING DRYWALL ENCLOSURE AROUND BEAM.
27	REMOVE EXISTING ELECTRICAL FLOOR BOXES. SEE ELECTRICAL DRAWINGS.
28	REMOVE EXISTING SIGNAGE; BY OWNER.
29	REMOVE EXISTING RAISED PLATFORM.
30	REMOVE EXISTING RECESSED CEILING MOUNTED PROJECTOR SCREENS. TURN OVER TO OWNER.
31	REMOVE EXISTING WATER COOLER.
32	REMOVE EXISTING HOLLOW METAL WINDOW SYSTEM.
33	REMOVE EXISTING WALK-IN COOLER/FREEZER AND ALL ASSOCIATED PIPING AND EQUIPMENT. REFER TO ELEC/PLUMB/MECH DRAWINGS.
34	REMOVE EXISTING SHELVING.
35	REMOVE EXISTING CURTAIN AND ROD.
36	REMOVE EXISTING EQUIPMENT; REFER TO ELECTRICAL DRAWINGS.
37	REMOVE EXISTING ACCOUSTICAL WALL PANELS.
38	REMOVE EXISTING TILE RISERS, TREADS AND LANDINGS. SEE GENERAL NOTE #13 AND 21.
39	REMOVE EXISTING ELEVATOR WALL PANELS.
40	REMOVE EXISTING ELEVATOR FLOORING.
41	REMOVE EXISTING ELEVATOR CEILING.
42	REMOVE EXISTING ELEVATOR HANDRAILS.
43	REMOVE EXISTING BRICK AROUND COLUMN ENCLOSURE.
44	REMOVE EXISTING FIRE SUPPRESSION SYSTEM; SEE MECHANICAL DRAWINGS.
45	REMOVE EXISTING PENDANT LIGHT FIXTURE.
46	REMOVE EXISTING FLOOR DRAINS; SEE PLUMBING DRAWINGS.
47	REMOVE EXISTING CEILING MOUNTED MIRROR AND HARDWARE.
48	REMOVE EXISTING SOUND/PAK PANELS / WOOD TRIM / PLYWOOD PANELING / WOOD BASE SYSTEM; SEE GENERAL NOTE #12.
49	REMOVE EXISTING ACCOUSTICAL CEILING AT STAIRS. KEEP EXISTING GYPSUM BOARD SOFFIT AND CEILING; SEE GENERAL NOTE #14.
50	REMOVE EXISTING TV'S, BRACKETS AND ASSOCIATED HARDWARE; BY OWNER.
51	REMOVE EXISTING FLOOR DRAINS; REFER TO PLUMBING DRAWINGS.
52	REMOVE EXISTING WHITEBOARDS, TACKBOARDS, TACKSTRIPS, MAP RAILS AND DISPLAY CASES; BY OWNER.
53	REMOVE EXISTING LOCKERS; BY OWNER.
54	REMOVE EXISTING PIN LETTERING. TURN OVER TO OWNER.
55	REMOVE EXISTING SKYLIGHT WINDOW TREATMENT.
56	REMOVE EXISTING COUNTERTOP; STORE FOR LATER RE-INSTALLATION.
57	REMOVE EXISTING GLASS SMOKE CURTAIN.
58	REMOVE EXISTING SHED FRAMING, WALL PANELS, ROOFING SYSTEM, CONCRETE SLAB AND FOUNDATION SYSTEM IN ITS ENTIRETY. SEE GENERAL NOTE #16.
59	REMOVE EXISTING BLOCK/BRICK WALL DOWN TO EXISTING CONCRETE SLAB.
60	REMOVE AND RELOCATE EXISTING MECHANICAL UNIT. REFER TO MECHANICAL DRAWINGS.
61	

revisions		
no.	date	description
1	10/26/12	ADDENDUM #1

THE CONTRACTOR SHALL VERIFY ALL DIMENSIONS AND EXISTING CONDITIONS AT THE SITE BEFORE PROCEEDING WITH EACH PHASE OF HIS WORK. THIS DRAWING, AS AN INSTRUMENT OF SERVICE, IS AND SHALL REMAIN THE PROPERTY OF THE ARCHITECT.

© Murray Associates Architects, P.C.  
 CONSULTANT: OWNER'S REPRESENTATIVE  
 EASTERN PGM, LLC  
 645 N. 12TH STREET  
 SUITE 200  
 LEMOYNE, PA 17043  
 717-233-3616



ALTERATIONS TO  
 WILDWOOD  
 CONFERENCE CENTER  
 HARRISBURG AREA  
 COMMUNITY COLLEGE  
 HARRISBURG, PA

DRAWING INDEX AND  
 NOTES

EARLY DEMOLITION  
 PACKAGE

DRAWN BY: TAB  
 CHECKED BY: BHD

DATE:  
 OCTOBER 17, 2012

PROJECT NUMBER:  
 3395


SHEET NUMBER:  
 AO.1

revisions		
no.	date	description
1	10/26/12	ADDENDUM #1


THE CONTRACTOR SHALL VERIFY ALL DIMENSIONS AND EXISTING CONDITIONS AT THE SITE BEFORE PROCEEDING WITH EACH PHASE OF HIS WORK. THIS DRAWING, AS AN INSTRUMENT OF SERVICE, IS AND SHALL REMAIN THE PROPERTY OF THE ARCHITECT.

© Murray Associates Architects, P.C.

CONSULTANT: OWNER'S REPRESENTATIVE  
 EASTERN PGM, LLC  
 645 N. 12TH STREET  
 SUITE 200  
 LEMOYNE, PA 17043  
 717-233-3616

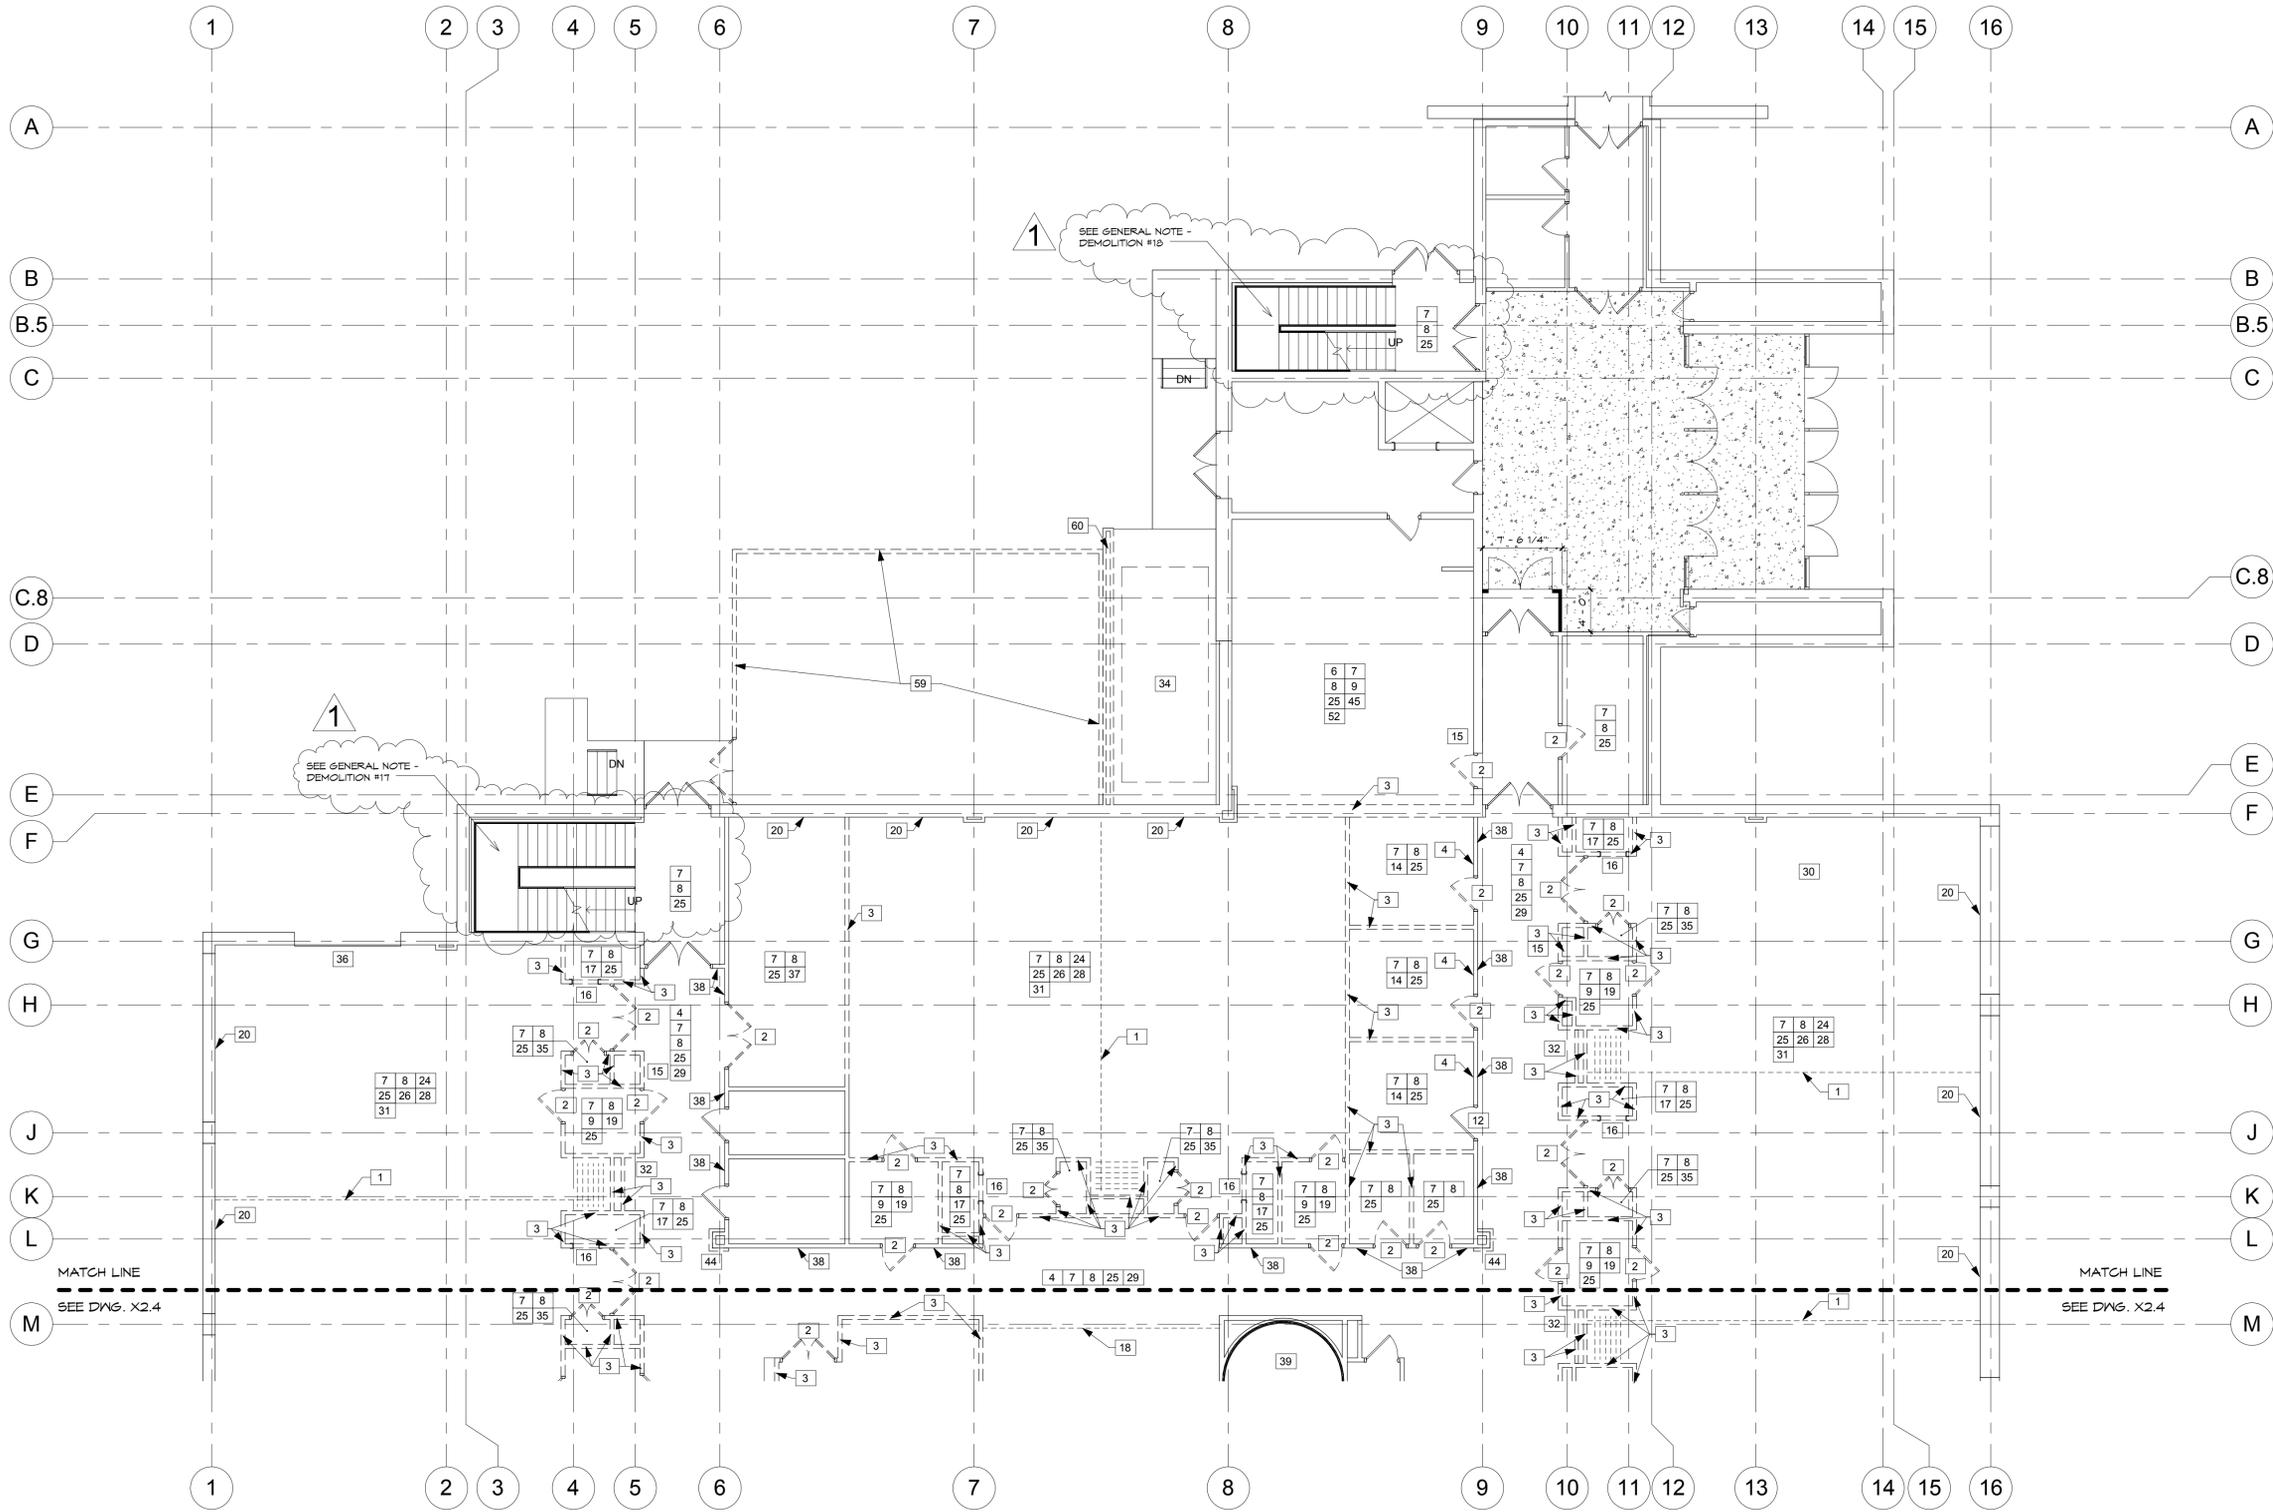

**LARGE SCALE FIRST FLOOR DEMOLITION PLAN - SECTION A**  
 SCALE: 1/8" = 1'-0"  
 NOTE: SEE DRAWING A0.1 FOR GENERAL NOTES - DEMOLITION AND DEMOLITION KEYNOTES.

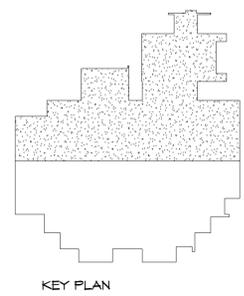

**ALTERATIONS TO WILDWOOD CONFERENCE CENTER HARRISBURG AREA COMMUNITY COLLEGE HARRISBURG, PA**

**LARGE SCALE FIRST FLOOR DEMOLITION PLAN - SECTION A**

**EARLY DEMOLITION PACKAGE**

DRAWN BY: TAB CHECKED BY: BHD

DATE: OCTOBER 17, 2012

PROJECT NUMBER: **3395**


SHEET NUMBER: **X2.3**

revisions		
no.	date	description
1	10/26/12	ADDENDUM #1

THE CONTRACTOR SHALL VERIFY ALL DIMENSIONS AND EXISTING CONDITIONS AT THE SITE BEFORE PROCEEDING WITH EACH PHASE OF HIS WORK. THIS DRAWING, AS AN INSTRUMENT OF SERVICE, IS AND SHALL REMAIN THE PROPERTY OF THE ARCHITECT.

© Murray Associates Architects, P.C.


CONSULTANT: OWNER'S REPRESENTATIVE  
 EASTERN PGM, LLC  
 645 N. 12TH STREET  
 SUITE 200  
 LEMOYNE, PA 17043  
 717-233-3616

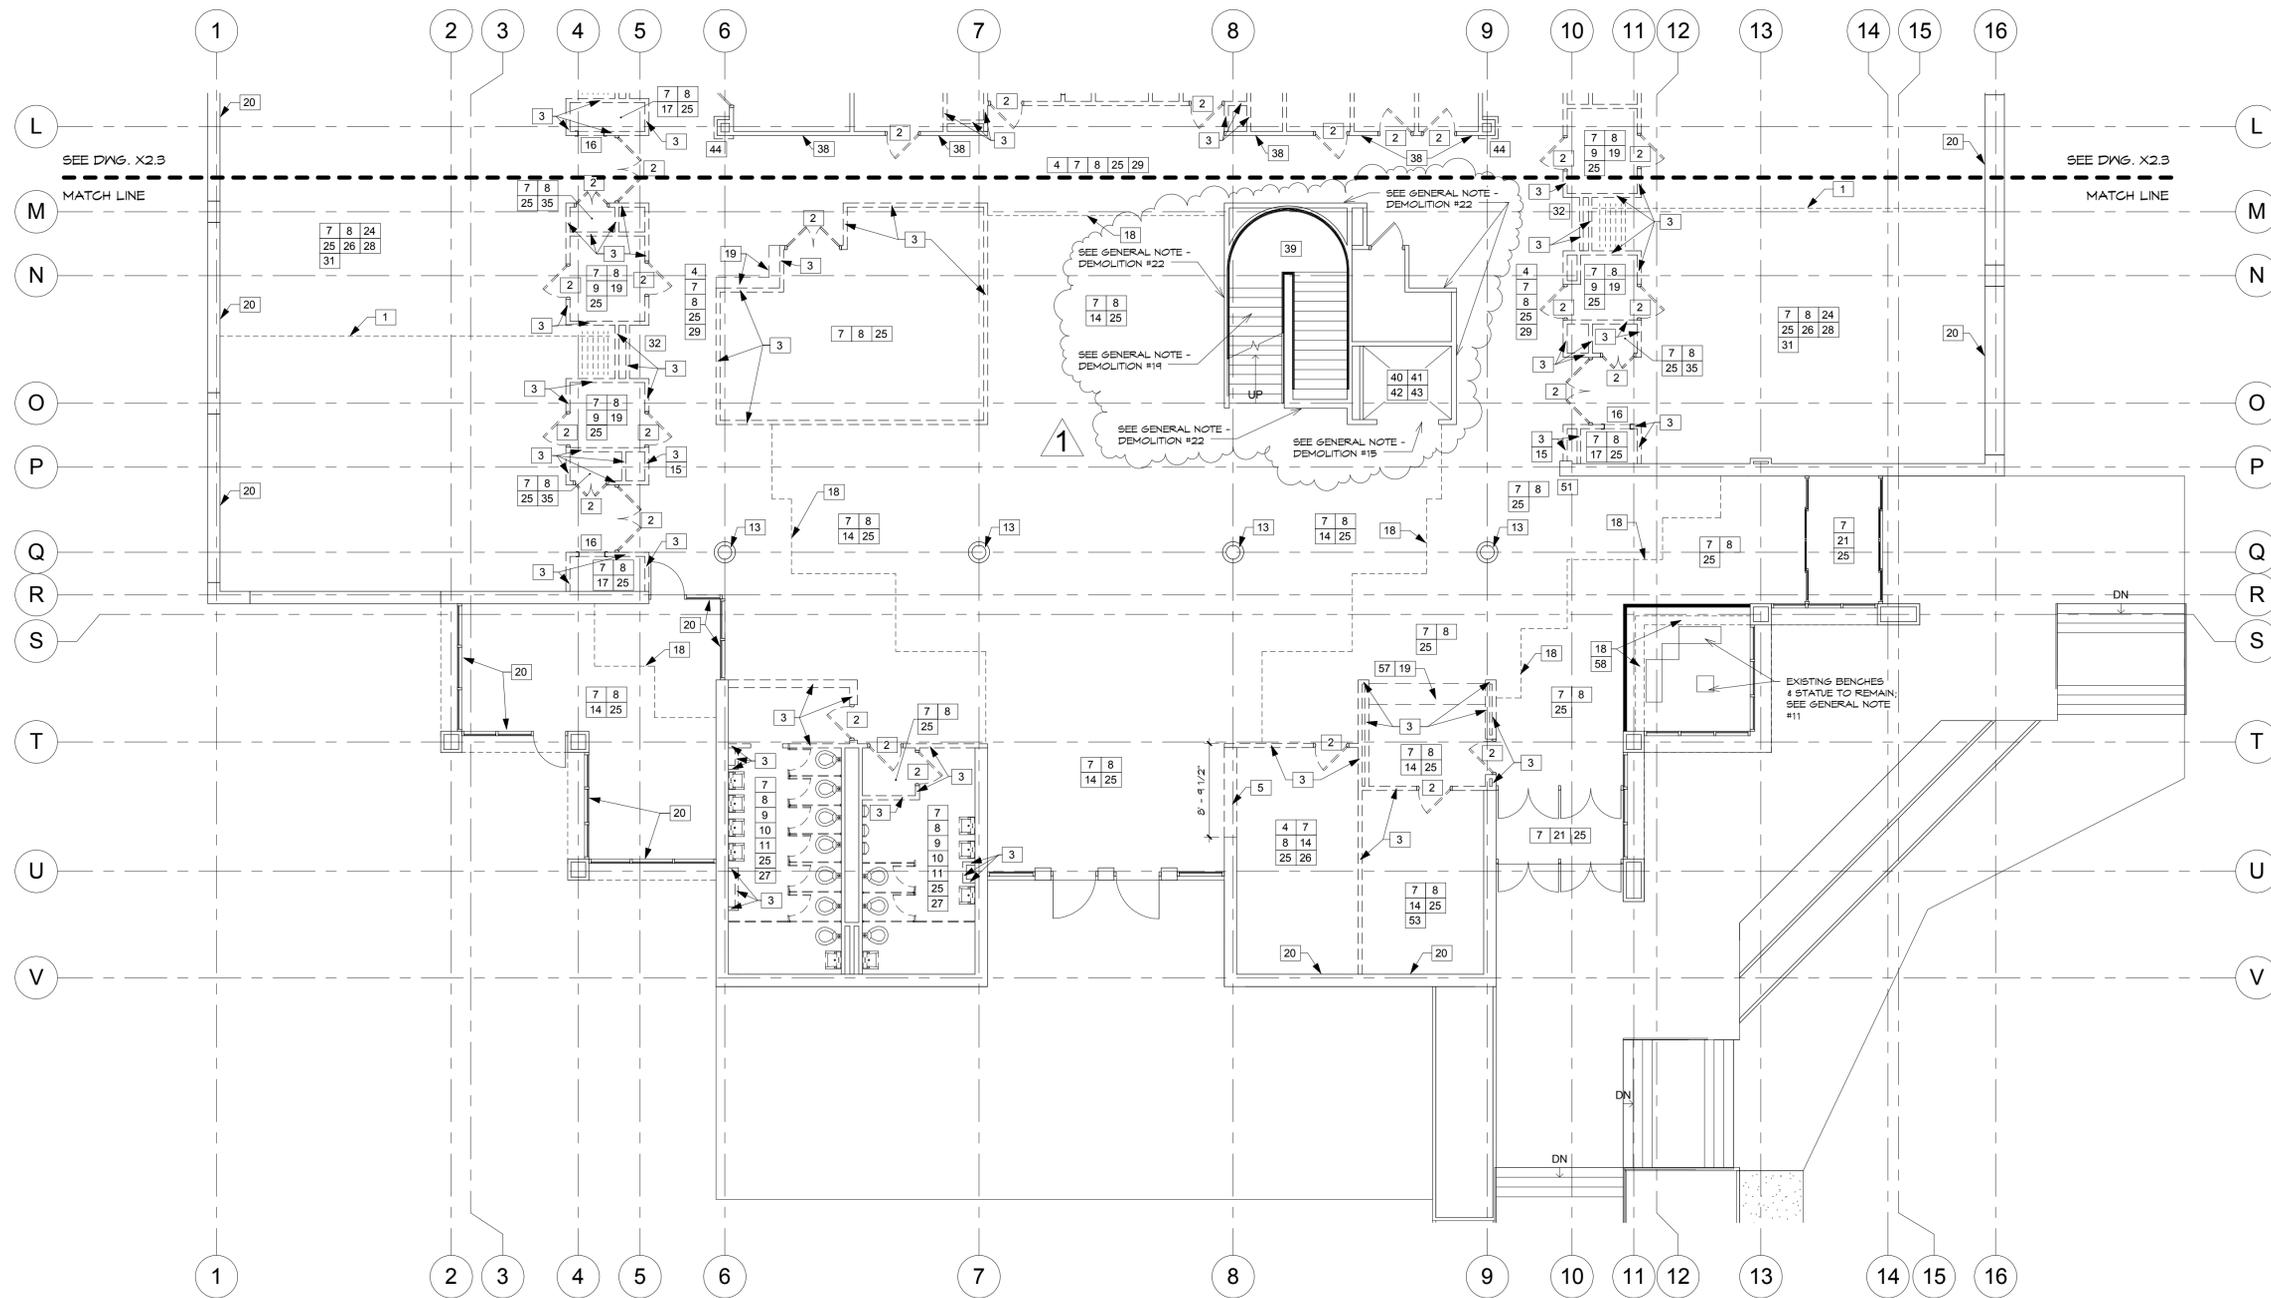

**LARGE SCALE FIRST FLOOR DEMOLITION PLAN - SECTION B**

SCALE: 1/8" = 1'-0"

NOTE: SEE DRAWINGS A0.1 FOR GENERAL NOTES - DEMOLITION AND DEMOLITION KEYNOTES.

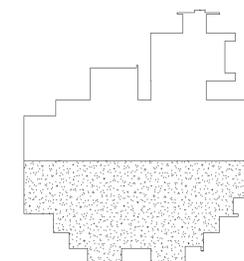

KEY PLAN



ALTERATIONS TO  
 WILDWOOD  
 CONFERENCE CENTER  
 HARRISBURG AREA  
 COMMUNITY COLLEGE  
 HARRISBURG, PA

LARGE SCALE FIRST  
 FLOOR DEMOLITION  
 PLAN - SECTION B

EARLY DEMOLITION  
 PACKAGE

DRAWN BY: TAB  
 CHECKED BY: BHD

DATE:  
 OCTOBER 17, 2012

PROJECT NUMBER:  
**3395**

SHEET NUMBER:  
**X2.4**

revisions		
no.	date	description
1	10/26/12	ADDENDUM #1

THE CONTRACTOR SHALL VERIFY ALL DIMENSIONS AND EXISTING CONDITIONS AT THE SITE BEFORE PROCEEDING WITH EACH PHASE OF HIS WORK. THIS DRAWING, AS AN INSTRUMENT OF SERVICE, IS AND SHALL REMAIN THE PROPERTY OF THE ARCHITECT.

© Murray Associates Architects, P.C.  
 CONSULTANT: OWNER'S REPRESENTATIVE  
 EASTERN PGM, LLC  
 645 N. 12TH STREET  
 SUITE 200  
 LEMOYNE, PA 17043  
 717-233-3616



ALTERATIONS TO  
 WILDWOOD  
 CONFERENCE CENTER  
 HARRISBURG AREA  
 COMMUNITY COLLEGE  
 HARRISBURG, PA

LARGE SCALE SECOND  
 FLOOR DEMOLITION  
 PLAN - SECTION A


EARLY DEMOLITION  
 PACKAGE

DRAWN BY: TAB  
 CHECKED BY: BHD


DATE:  
 OCTOBER 17, 2012

PROJECT NUMBER:  
 3395

SHEET NUMBER:  
 X2.5

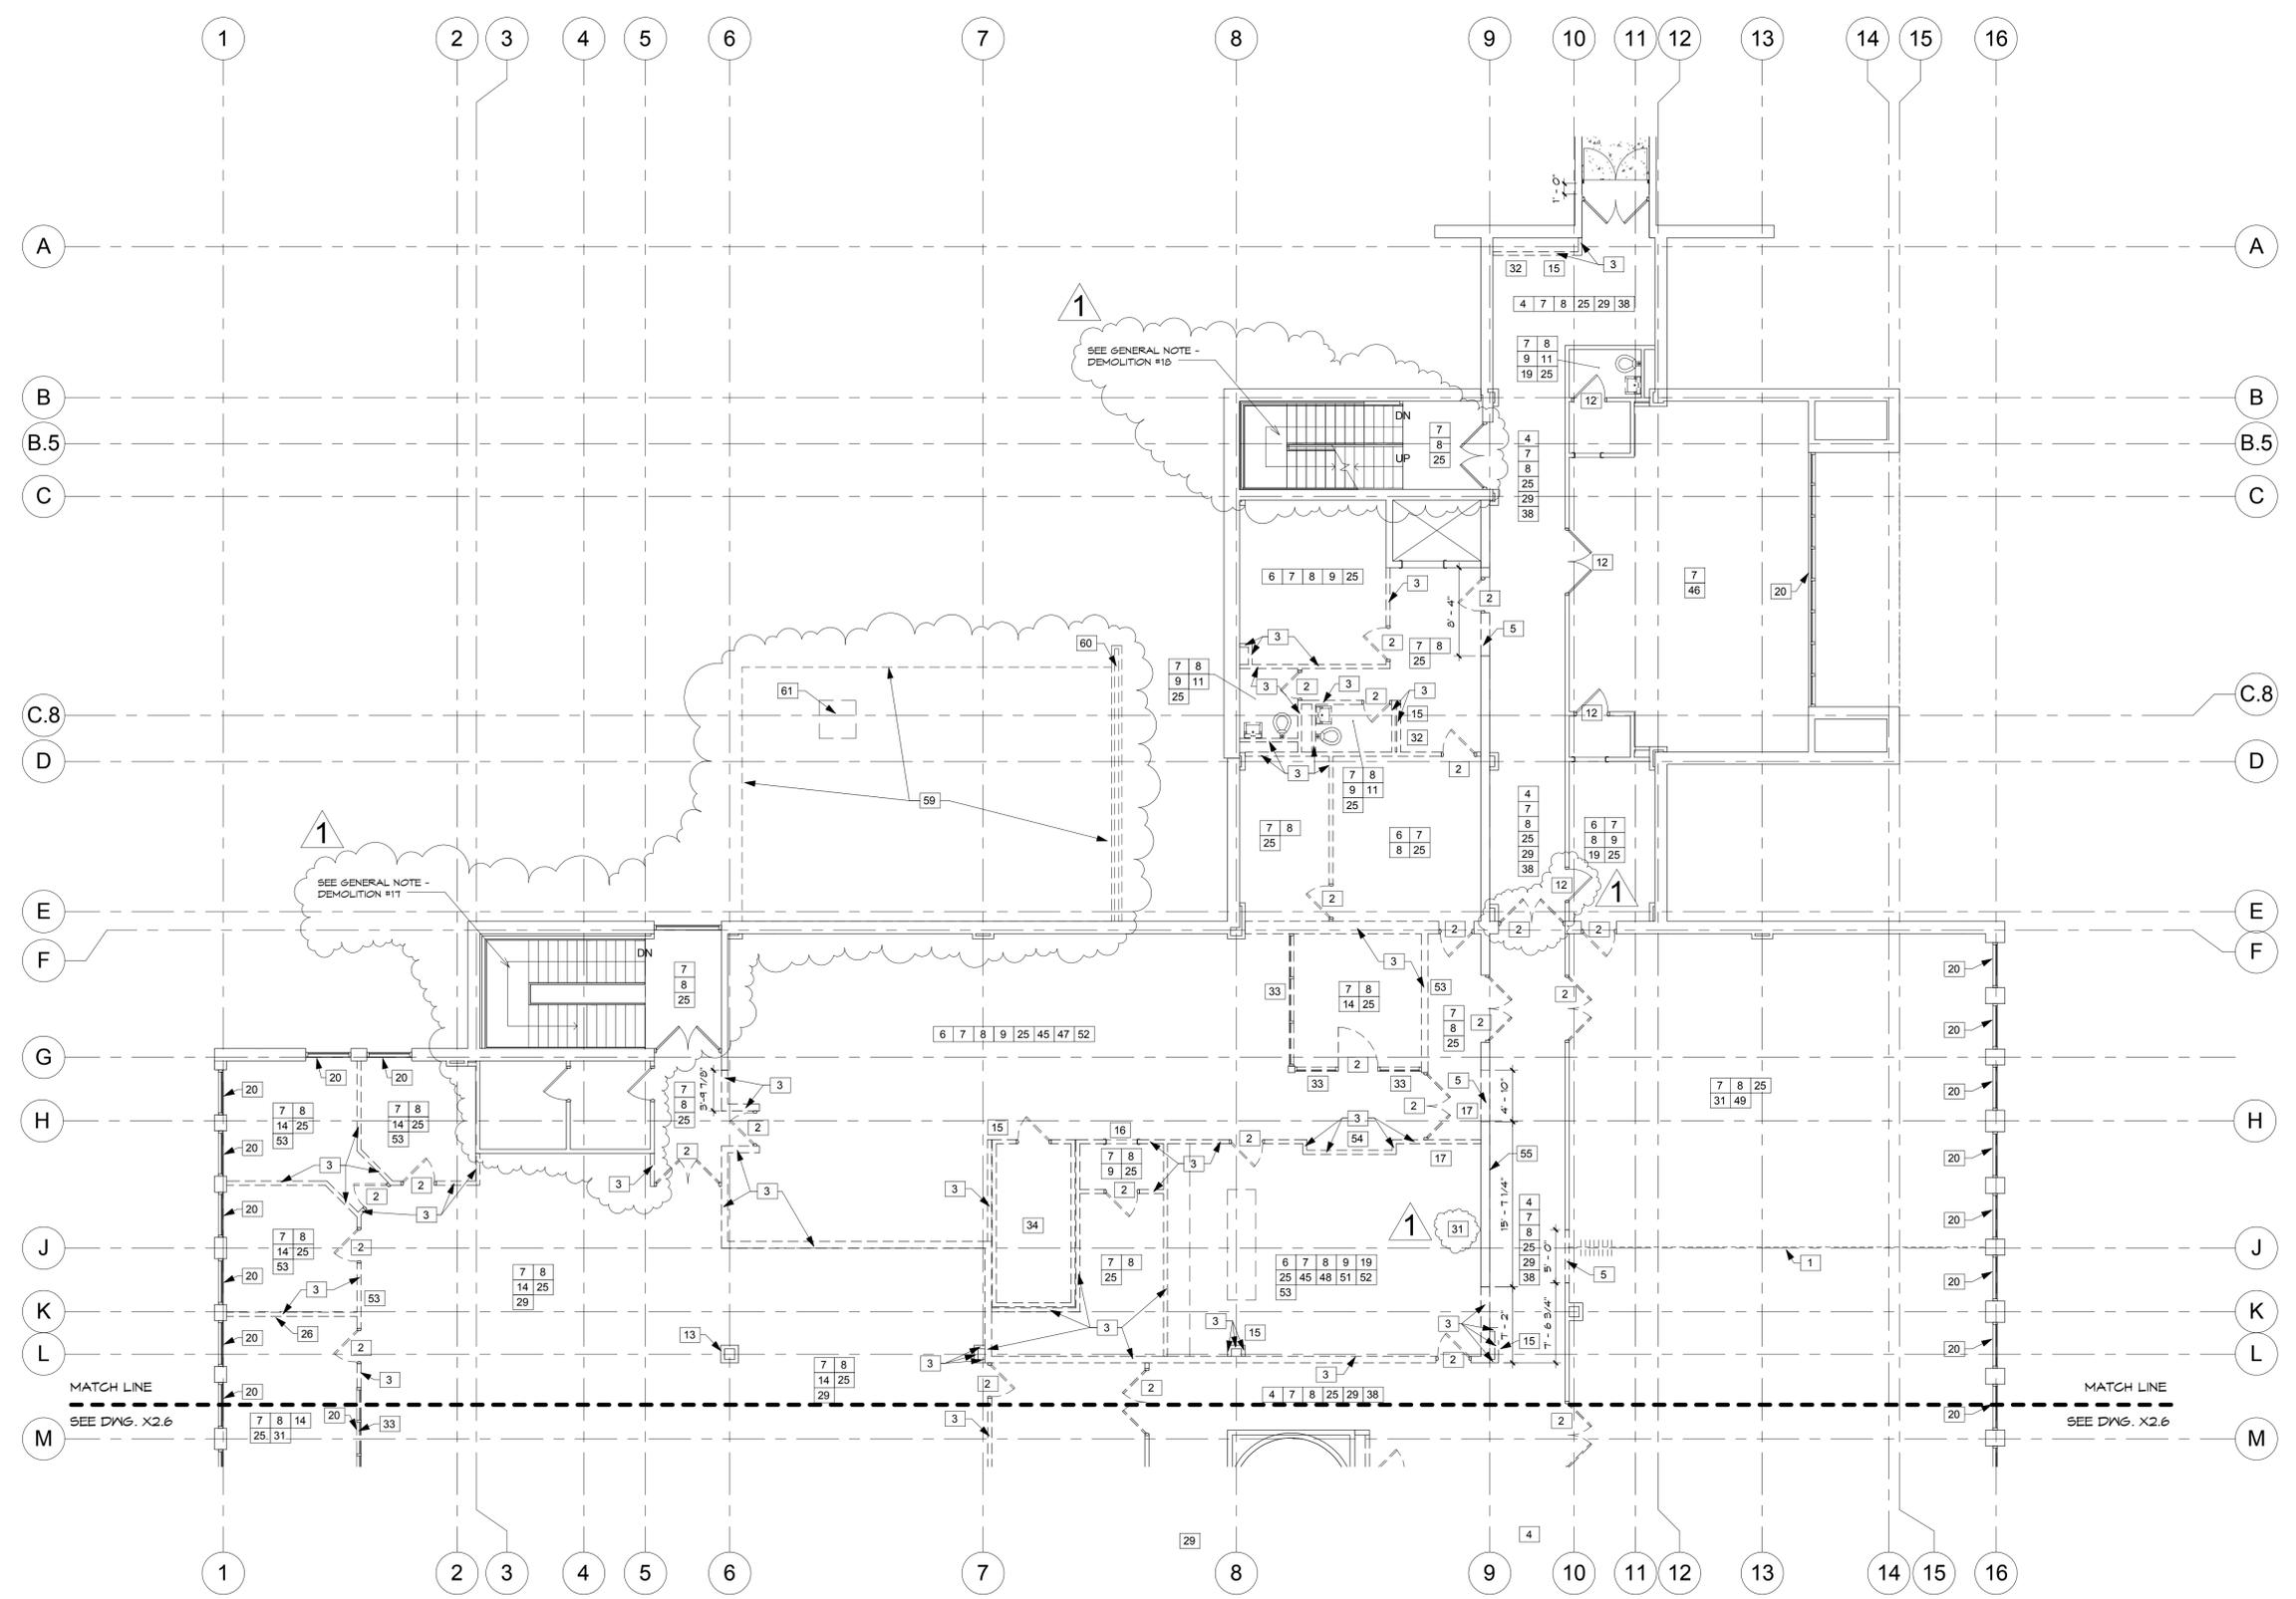

**LARGE SCALE SECOND FLOOR DEMOLITION PLAN - SECTION A**  
 SCALE: 1/8" = 1'-0"  
 NOTE: SEE DRAWING A0.1 FOR GENERAL NOTES - DEMOLITION AND DEMOLITION KEYNOTES.

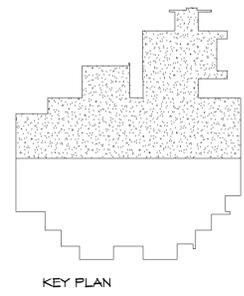

revisions		
no.	date	description
1	10/26/12	ADDENDUM #1

THE CONTRACTOR SHALL VERIFY ALL DIMENSIONS AND EXISTING CONDITIONS AT THE SITE BEFORE PROCEEDING WITH EACH PHASE OF HIS WORK. THIS DRAWING, AS AN INSTRUMENT OF SERVICE, IS AND SHALL REMAIN THE PROPERTY OF THE ARCHITECT.

© Murray Associates Architects, P.C.

CONSULTANT: OWNER'S REPRESENTATIVE  
 EASTERN PGM, LLC  
 645 N. 12TH STREET  
 SUITE 200  
 LEMOYNE, PA 17043  
 717-233-3616



ALTERATIONS TO WILDWOOD CONFERENCE CENTER HARRISBURG AREA COMMUNITY COLLEGE HARRISBURG, PA

LARGE SCALE SECOND FLOOR DEMOLITION PLAN - SECTION B


EARLY DEMOLITION PACKAGE

DRAWN BY: TAB CHECKED BY: BHD

DATE: OCTOBER 17, 2012

PROJECT NUMBER: 3395


SHEET NUMBER: X2.6

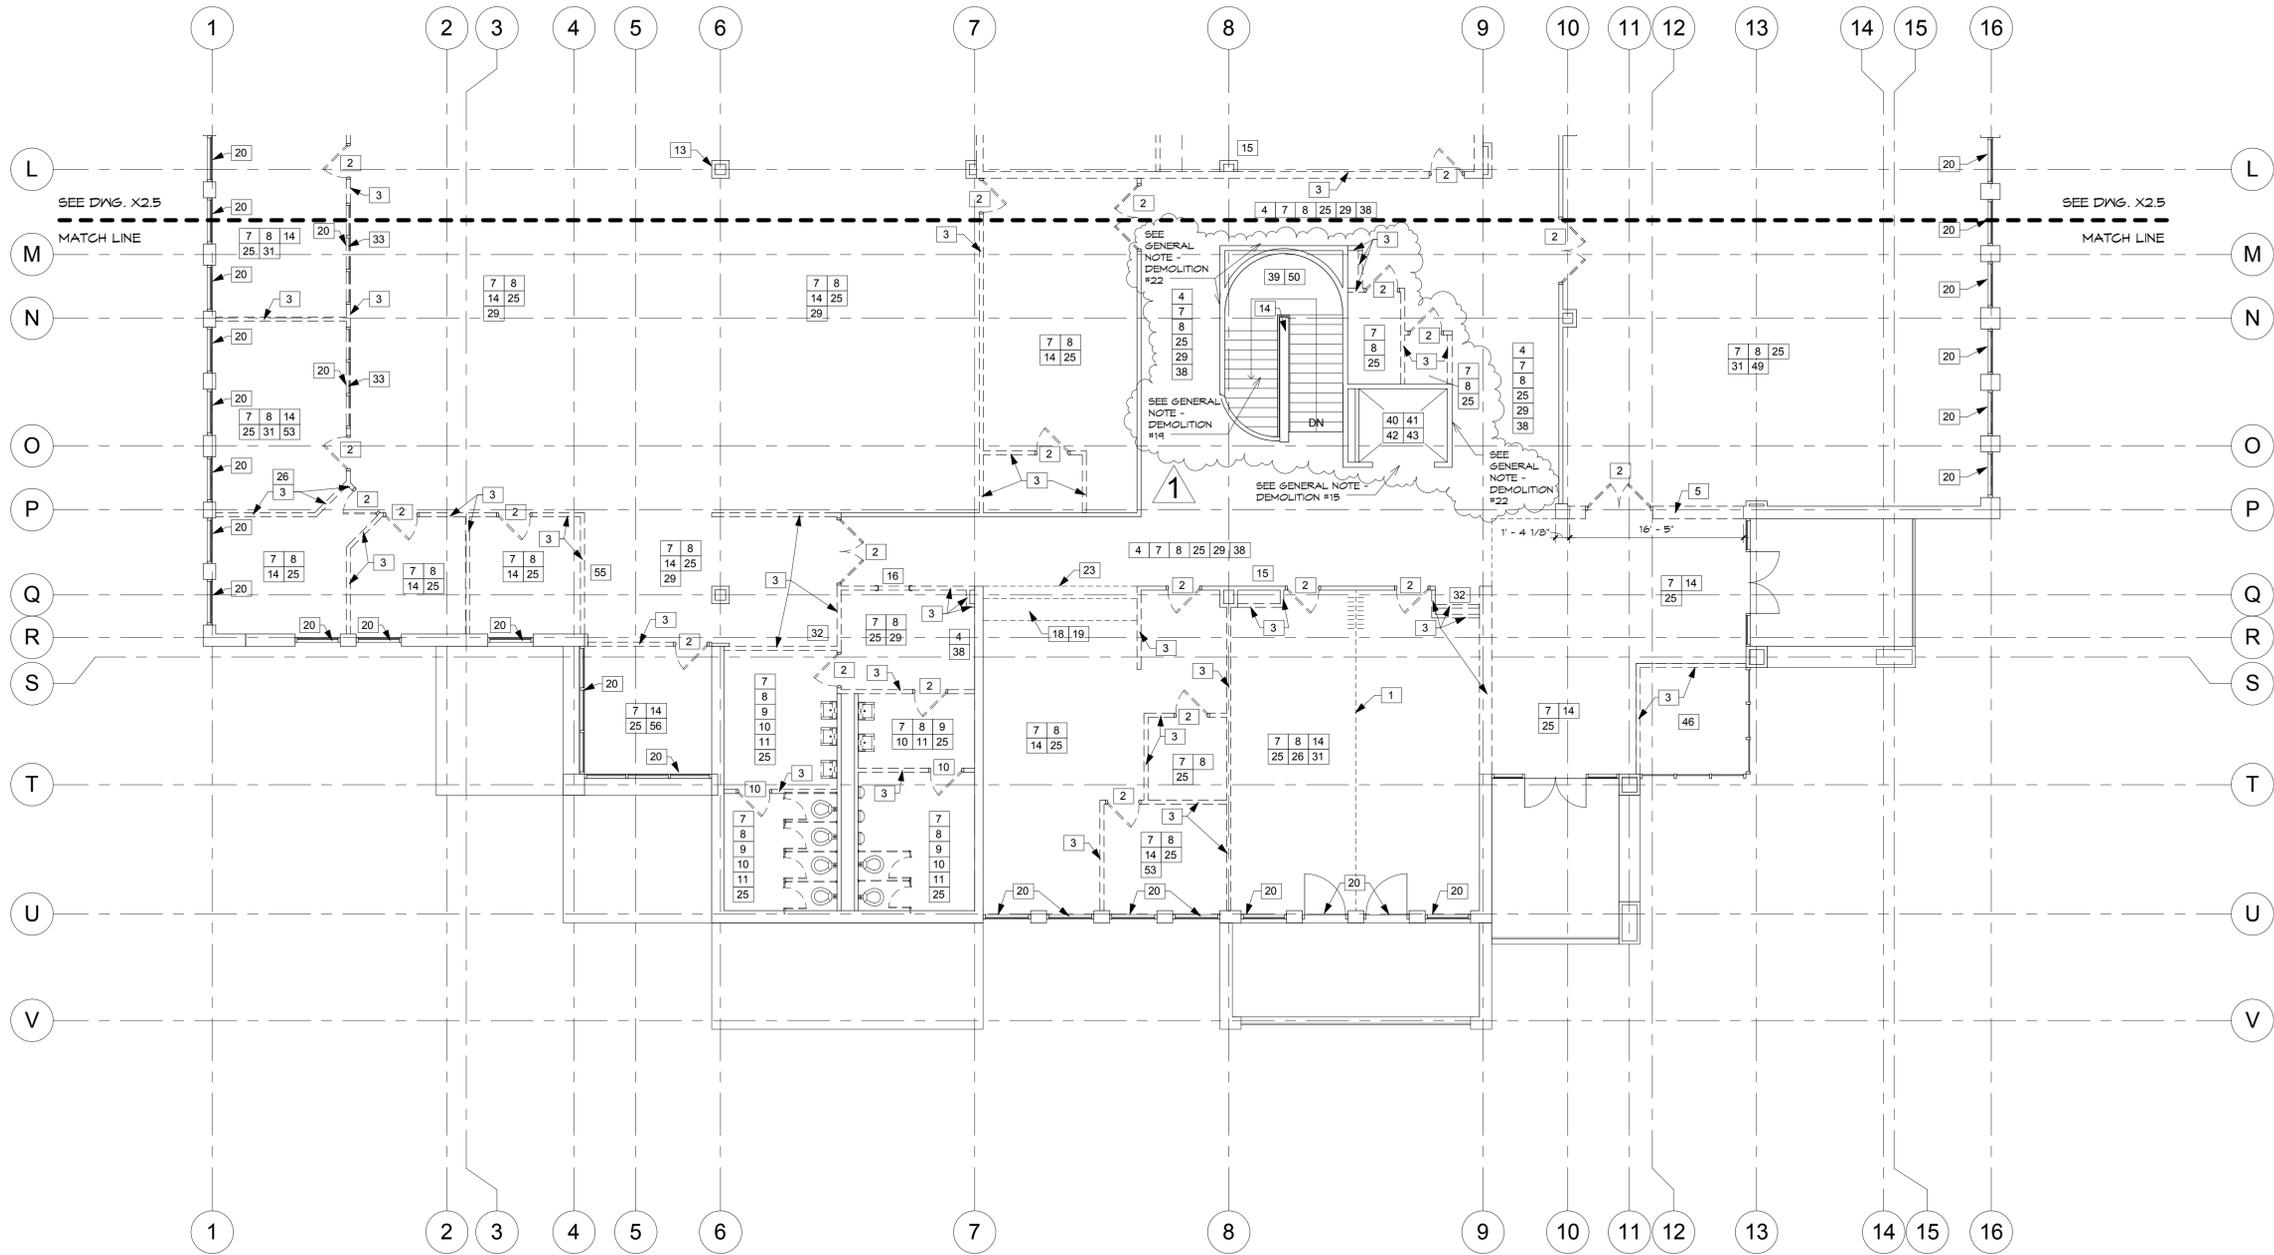

LARGE SCALE SECOND FLOOR DEMOLITION PLAN - SECTION B

SCALE: 1/8" = 1'-0"

NOTE: SEE DRAWING A0.1 FOR GENERAL NOTES - DEMOLITION AND DEMOLITION KEYNOTES.


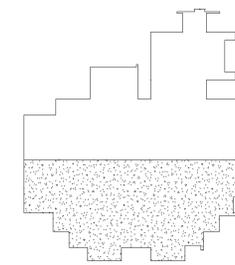


KEY PLAN

HACC Central Administration  
 Wildwood Conference Center Renovations  
 Items Scheduled for Salvage  
 10/30/2012

No.	Item	Responsible		Notes
		Entity	Intent	
1	Food Service Equip	HACC FMD	Storage	Will be removed prior to Demolition
2	Furniture	HACC FMD	Storage	Will be removed prior to Demolition
3	Artwork	HACC FMD	Storage	Will be removed prior to Demolition
4	Tackboards	HACC FMD	Storage	Will be removed prior to Demolition
5	Map Rails	HACC FMD	Storage	Will be removed prior to Demolition
6	Tack Strips	HACC FMD	Storage	Will be removed prior to Demolition
7	Display Cases	HACC FMD	Storage	Will be removed prior to Demolition
8	Lockers	<b>Contractor</b>	To HACC	Palletize and deliver to HACC
9	Planters	HACC FMD	Storage	Will be removed prior to Demolition
10	TV's/Brackets	HACC FMD	Storage	Will be removed prior to Demolition
11	Stone countertop	<b>Contractor</b>	Remain	Protect in place
12	Statue	<b>Contractor</b>	Remain	Protect in place
13	Signage	HACC FMD	Storage	Will be removed prior to Demolition
14	Projection Screens	<b>Contractor</b>	To HACC	Palletize and deliver to HACC
15	Cherry doors/hardware	<b>Contractor</b>	To HACC	Palletize and deliver to HACC
16	Cherry trim/paneling	<b>Contractor</b>	To HACC	Palletize and deliver to HACC
18	Culinary Signage letters	<b>Contractor</b>	To HACC	Palletize and deliver to HACC
19	Fire alarm devices	<b>Contractor</b>	To HACC	Palletize and deliver to HACC
20	Fire extinguishers/cabinets	<b>Contractor</b>	To HACC	Palletize and deliver to HACC
21	Toilet accessories	<b>Contractor</b>	To HACC	Palletize and deliver to HACC
22	drinking fountains	<b>Contractor</b>	To HACC	Palletize and deliver to HACC
23	coat racks	HACC FMD	Storage	Will be removed prior to Demolition
24	shelving	HACC FMD	Storage	Will be removed prior to Demolition
25	Rugs	HACC FMD	Storage	Will be removed prior to Demolition
29	Thermostats	HACC FMD	Storage	Will be removed prior to Demolition
30	Breakers in dimming racks	HACC FMD	Storage	Will be removed prior to Demolition
31	Incandescent wall dimmers	HACC FMD	Storage	Will be removed prior to Demolition
32	120v GFI receptacles	HACC FMD	Storage	Will be removed prior to Demolition
33	LED exit signs	HACC FMD	Storage	Will be removed prior to Demolition
34	2'x4' fluorescent troffers	HACC FMD	Storage	30 - 50 fixtures will be removed prior to Demolition
35	4" recessed light fixtures	HACC FMD	Storage	Approx. 30 fixtures will be removed prior to Demolition
36	Water source heat pumps	HACC FMD / <b>Contractor</b>	pull parts	Contractor shall stage all heat pumps at the project site for (5) days and provide access for Owner to remove parts.
37	Audio/Visual Equipment	HACC FMD	Storage	Will be removed prior to Demolition



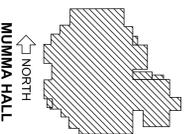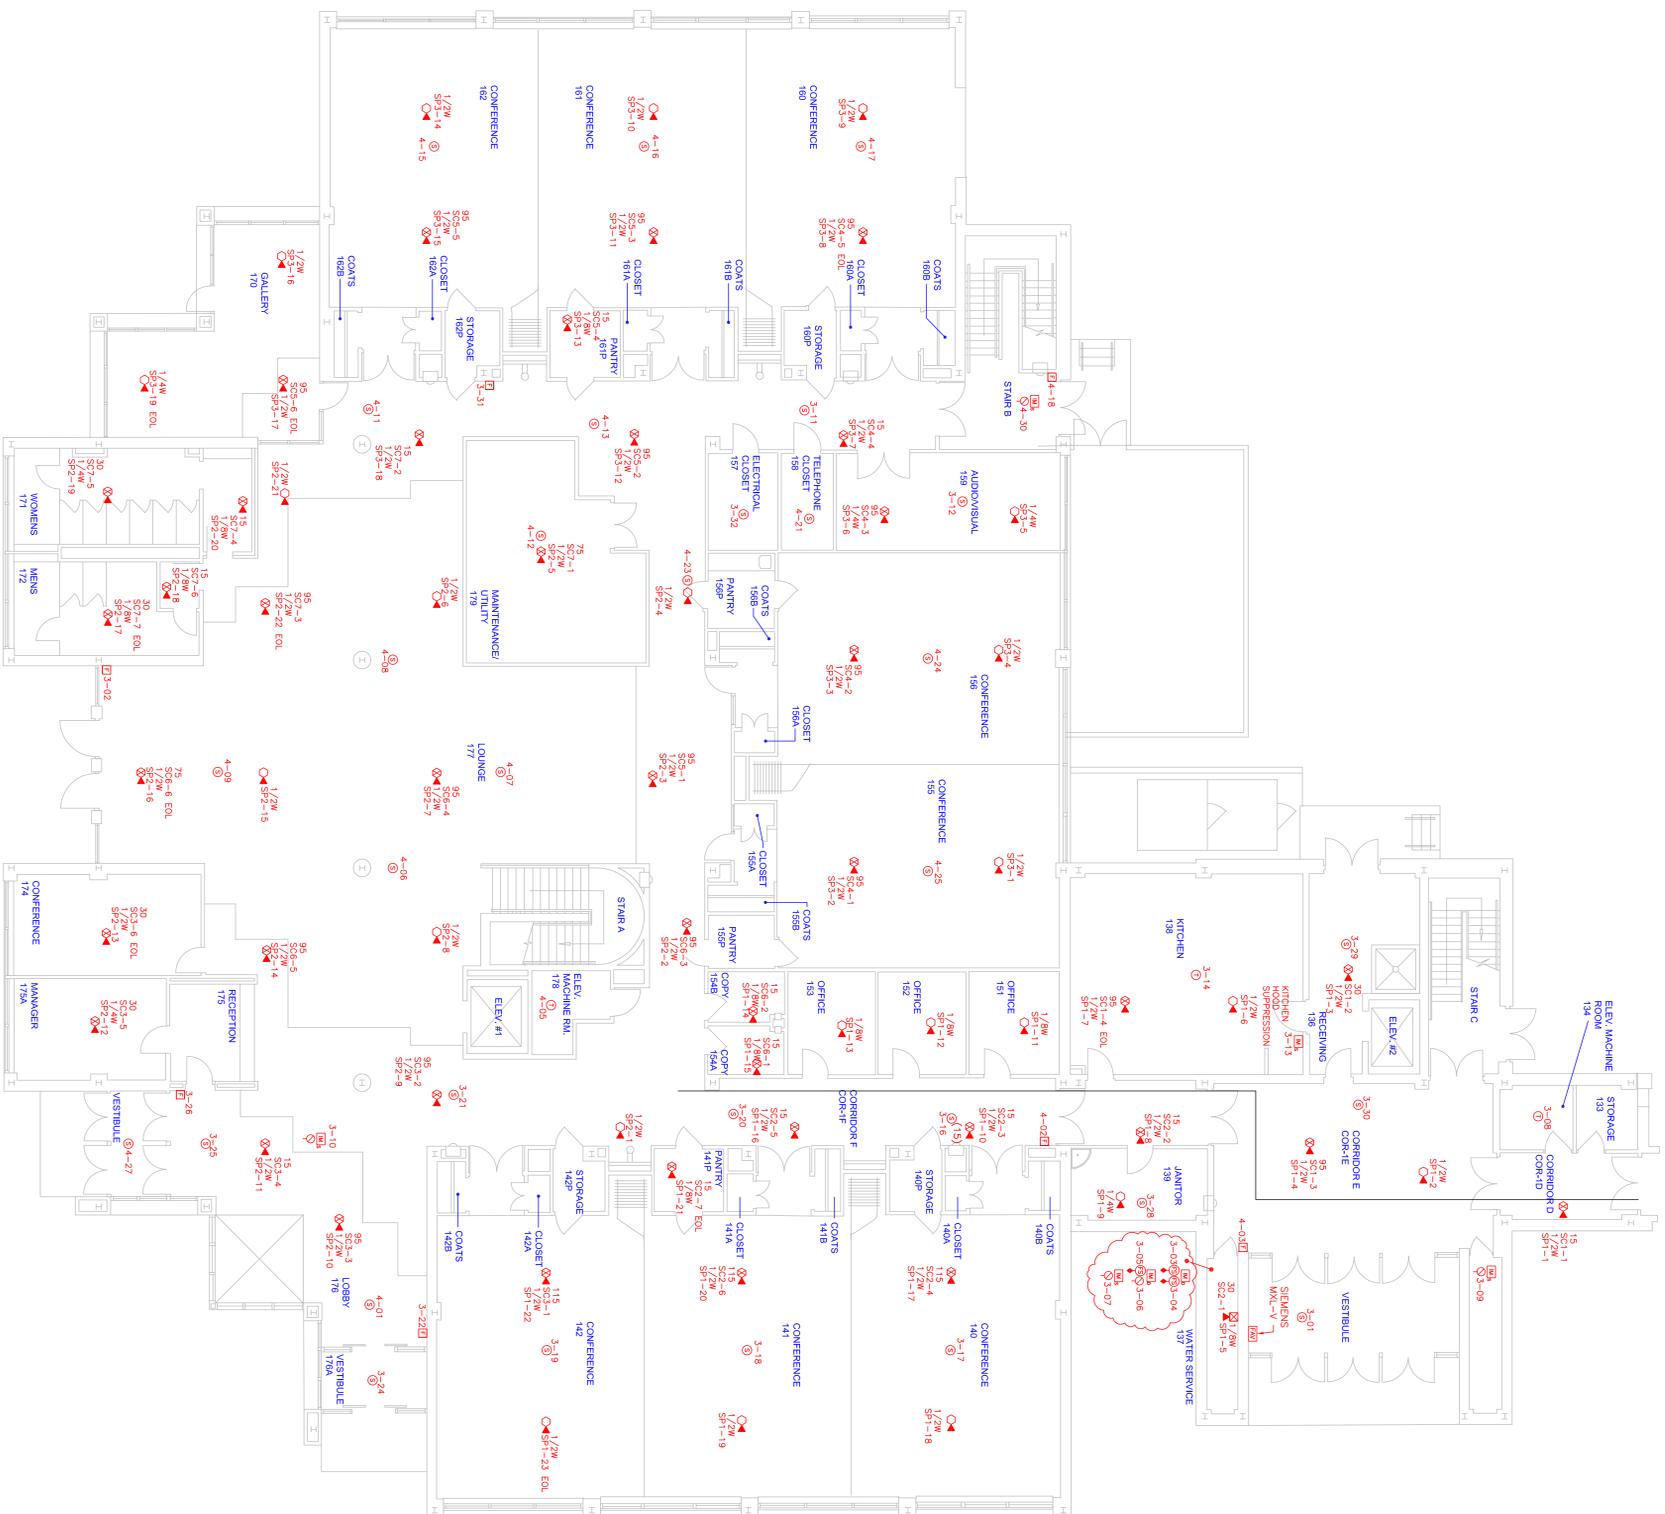

**CEILING HEIGHTS**

CORRIDORS	8'-0"
ROOMS & OFFICES	9'-0"
ENTRANCE & ROOM 240	11'-0"
2ND DINING & CONFERENCE RM	11'-6"
PENTHOUSE	16'-0"

**LEGEND**

- ☒ WALL STROBE
- ☒ CEILING STROBE
- ☒ WALL SPEAKER
- ☒ CEILING SPEAKER
- ☒ WALL SPEAKER STROBE
- ☒ CEILING SPEAKER STROBE
- ☒ HEAT DETECTOR
- ☒ SMOKE DETECTOR
- ☒ DUCT SMOKE DETECTOR
- ☒ FIRE ALARM PANEL
- ☒ FIRE ALARM ANNUNCIATOR
- ☒ AMPLIFIER PANEL
- ☒ FIRE ALARM ANNUNCIATOR PANEL
- ☒ FIRE ALARM VOICE PANEL
- ☒ FIRE GRAPHIC ANNUNCIATOR PANEL
- ☒ MANUAL PULL STATION

THESE DRAWINGS ARE PREPARED PER PLANS AND SPECIFICATIONS FOR THIS PROJECT. THEY HAVE NOT BEEN REVIEWED FOR STATE AND LOCAL CODE COMPLIANCE.

**Berkshire Systems Group, Inc.**  
 Corporate Office Telephone: 610 775-1200  
 50 South Museum Road Fax: 610-775-9648  
 Reading, PA 19607 www.berkshiresgi.com

FOR THE USE OF PRODUCTS SUPPLIED BY BERKSHIRE SYSTEMS GROUP INC. ANY OTHER USE, MODIFICATION OR REPRODUCTION OF THIS PRINT IS PROHIBITED WITHOUT WRITTEN CONSENT OF BERKSHIRE SYSTEMS GROUP INC. A FEE WILL BE CHARGED FOR OTHER USE OR REPRODUCTION OF THIS PRINT.



DRAWING FILE: MUMMA HALL-WILDWOOD CONFERENCE CTR

ID.	DATE:	REVISIONS:	ID.	DATE:	REVISIONS:
DHS	10/13/11	DRAWINGS OF RECORD			

PROJECT: HARRISBURG AREA COMMUNITY COLLEGE MUMMA HALL-WILDWOOD CONF CTR HARRISBURG PA

TITLE: FIRST FLOOR FIRE ALARM LAYOUT

DRAWING NUMBER: FA19.100

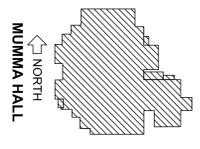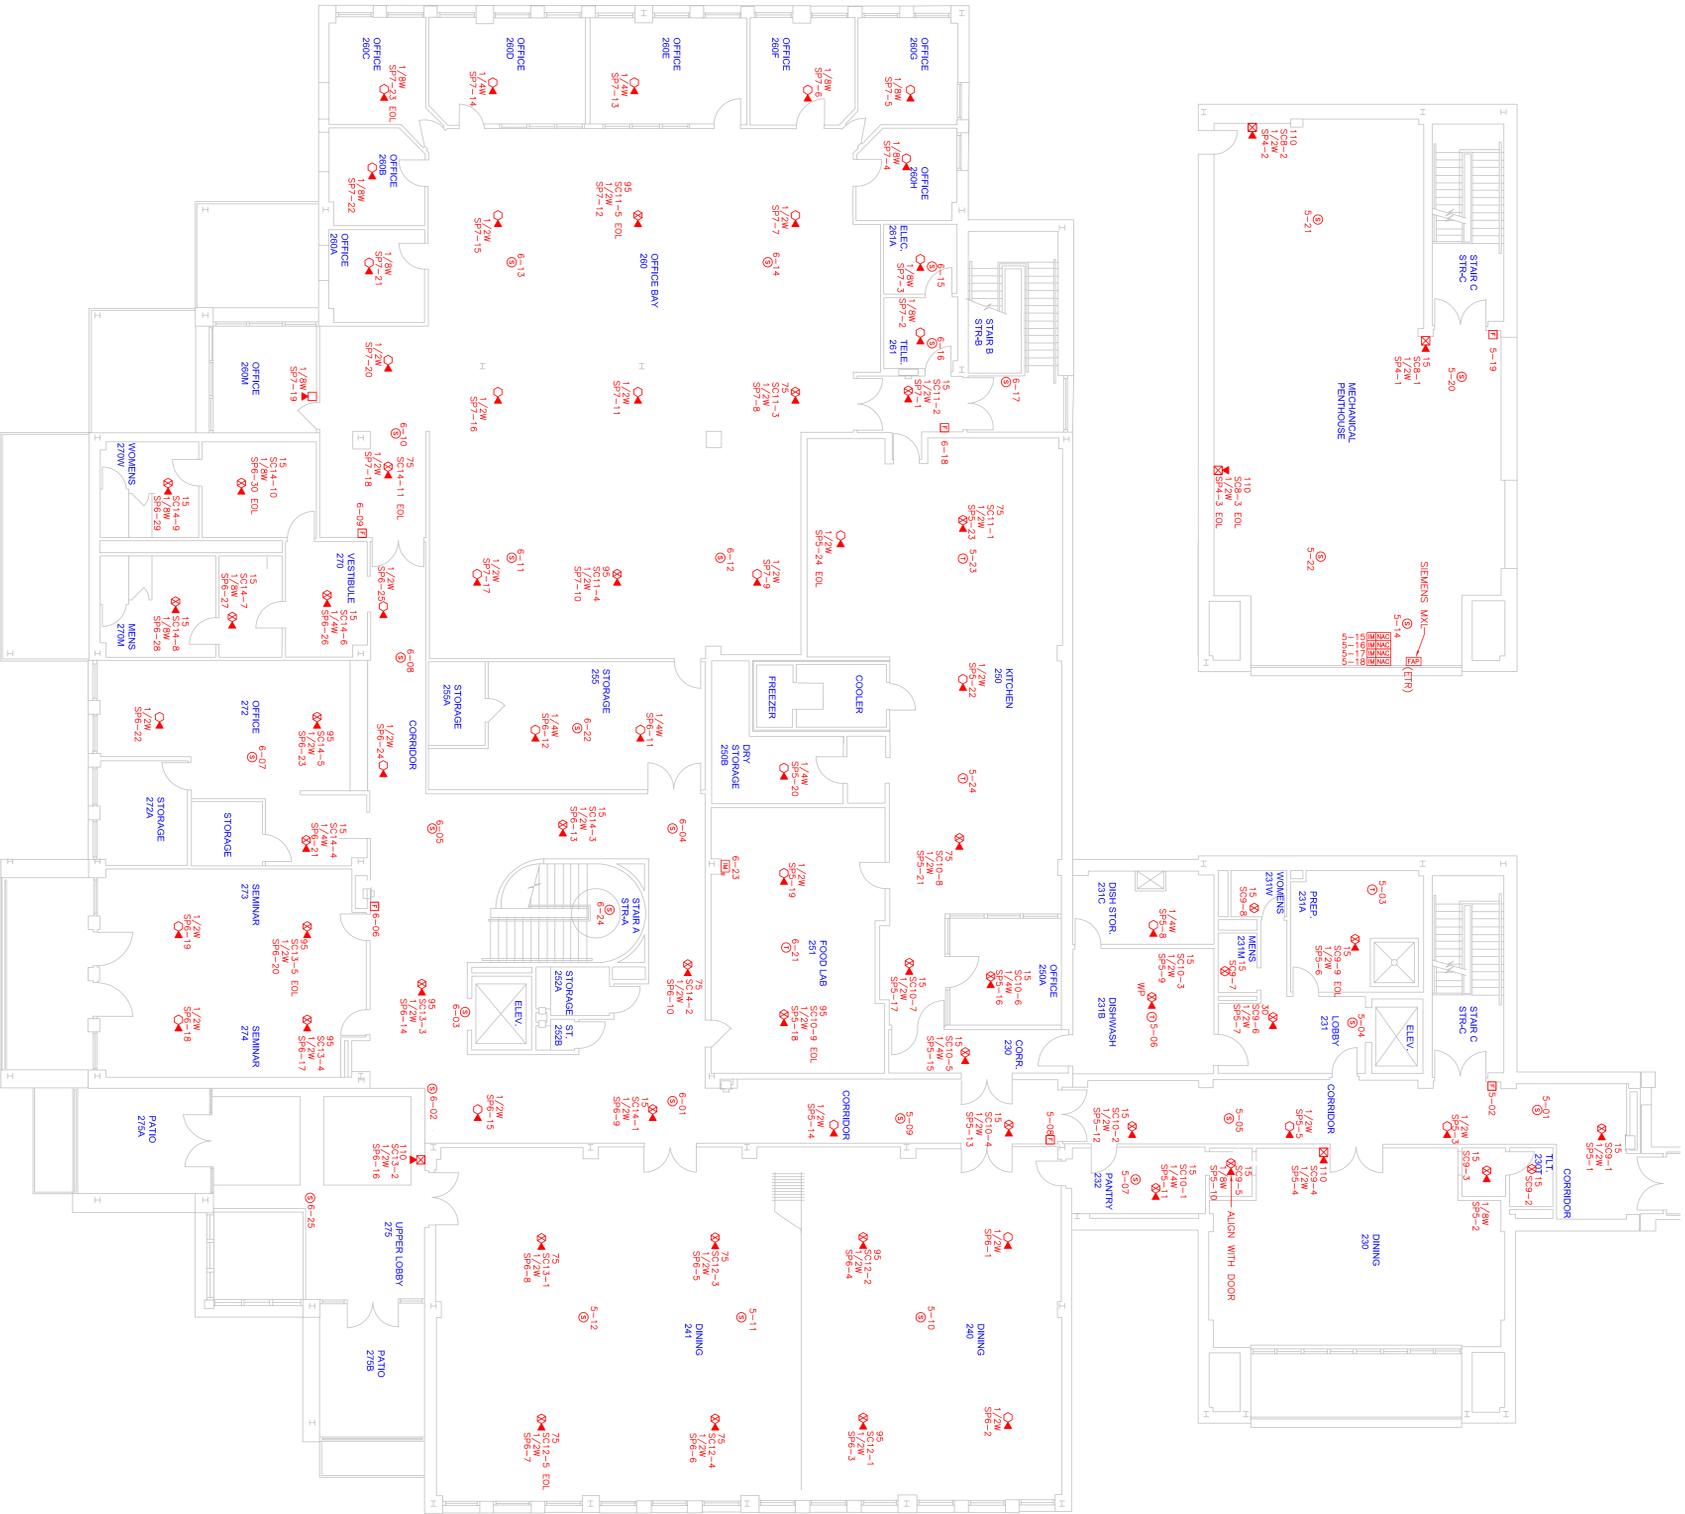

**CEILING HEIGHTS**

CORRIDORS	8'-0"
ROOMS & OFFICES	9'-0"
ENTRANCE & ROOM 240	11'-0"
2ND DINING & CONFERENCE RM	11'-6"
PENTHOUSE	16'-0"

- LEGEND**
- ☒ WALL STROBE
  - ☒ CEILING STROBE
  - ☒ WALL SPEAKER
  - ☒ CEILING SPEAKER
  - ☒ WALL SPEAKER STROBE
  - ☒ CEILING SPEAKER STROBE
  - ☒ HEAT DETECTOR
  - ☒ SMOKE DETECTOR
  - ☒ DUCT SMOKE DETECTOR
  - ☒ FIRE ALARM PANEL
  - ☒ FIRE ALARM ANNUNCIATOR
  - ☒ AMPLIFIER PANEL
  - ☒ STROBE CIRCUIT POWER EXTENDER PANEL
  - ☒ FIRE ALARM ANNUNCIATOR PANEL
  - ☒ FIRE ALARM VOICE PANEL
  - ☒ FIRE GRAPHIC ANNUNCIATOR PANEL
  - ☒ MANUAL PULL STATION

THESE DRAWINGS ARE PREPARED PER PLANS AND SPECIFICATIONS FOR THIS PROJECT. THEY HAVE NOT BEEN REVIEWED FOR STATE AND LOCAL CODE COMPLIANCE.

PROJECT: HARRISBURG AREA COMMUNITY COLLEGE MUMMA HALL-WILDWOOD CONF CTR HARRISBURG PA

DRAWING NUMBER: FA19.101

TITLE: SECOND FLOOR FIRE ALARM LAYOUT

**Berkshire Systems Group, Inc.**  
 Corporate Office: 50 South Museum Road, Reading, PA 19607  
 Telephone: 610 775-1200, Fax: 610-775-9648, www.berkshiresystems.com

FOR THE USE OF PRODUCTS SUPPLIED BY BERKSHIRE SYSTEMS GROUP INC. ANY OTHER USE, MODIFICATION OR REPRODUCTION OF THIS PRINT IS PROHIBITED WITHOUT WRITTEN CONSENT OF BERKSHIRE SYSTEMS GROUP INC. A FEE WILL BE CHARGED FOR OTHER USE OR REPRODUCTION OF THIS PRINT.

DRAWING FILE: MUMMA HALL-WILDWOOD CONFERENCE CTR

ID.	DATE:	REVISIONS:	ID.	DATE:	REVISIONS:
DHS-10	10/13/11	DRAWINGS OF RECORD			


SCALE: 1/8" = 1' - 0"

DATE: 1/24/2011


JOB NUMBER: DJP02795






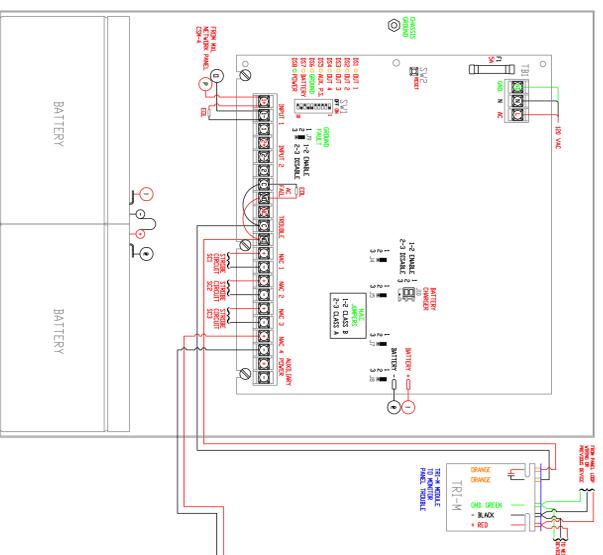


PAD-3 FIRE ALARM STROBE PANEL  
 LOCATION: MECHANICAL PENTHOUSE  
 ELECTRICAL PANEL CEN, LOCATED IN MECH PENIT, BREAKER #2

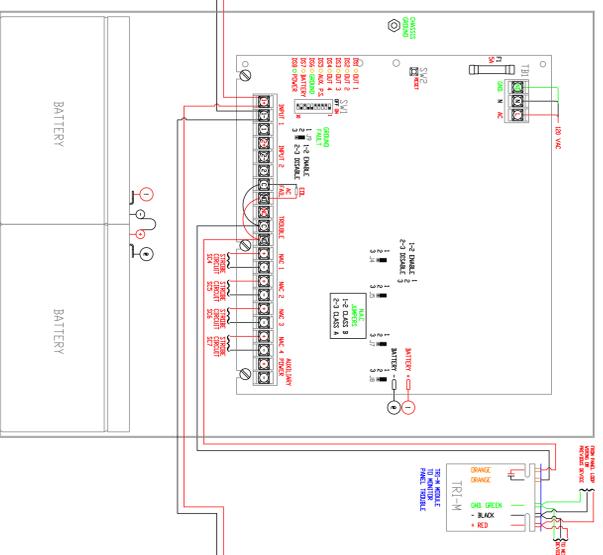

PAD-3 FIRE ALARM STROBE PANEL  
 LOCATION: MECHANICAL PENTHOUSE  
 ELECTRICAL PANEL CEN, LOCATED IN MECH PENIT, BREAKER #2

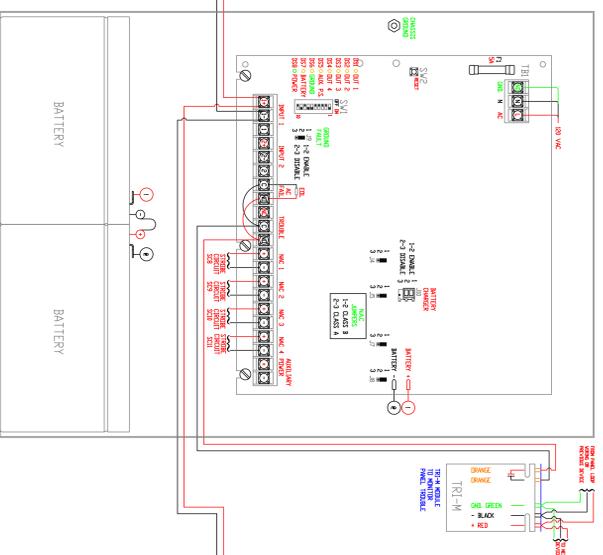

PAD-3 FIRE ALARM STROBE PANEL  
 LOCATION: MECHANICAL PENTHOUSE  
 ELECTRICAL PANEL CEN, LOCATED IN MECH PENIT, BREAKER #1

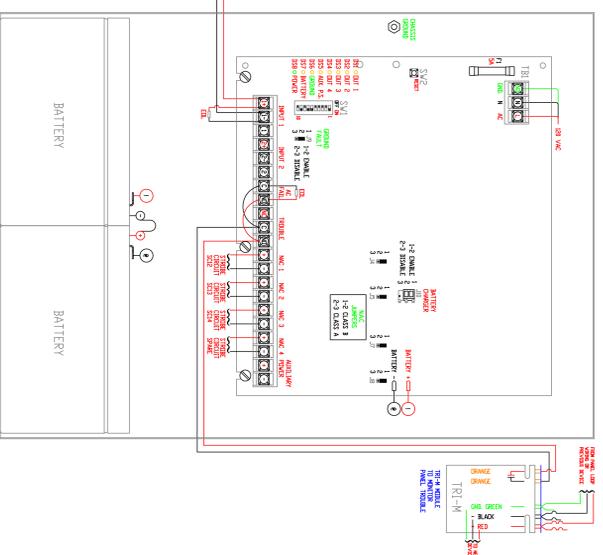

PAD-3 FIRE ALARM STROBE PANEL  
 LOCATION: MECHANICAL PENTHOUSE  
 ELECTRICAL PANEL CEN, LOCATED IN MECH PENIT, BREAKER #1

PANEL: MXLV FIRE ALARM CONTROL PANEL  
 LOCATION: VESTIBULE

Qty	Part Number	Description	Supv Current	Alarm Current	Total Supv Alarm
1	MMB-3	MAIN CONTROL	0.280	3.280	3.280
1	MMB-5	MAIN DISPLAY	0.300	0.300	0.300
1	ACM-1	AUDIO CONTROL MODULE	0.085	0.085	0.085
2	VSM-1	SWITCH MODULE	0.017	0.160	0.034
1	DMC-1	DIGITAL MESSAGE MODULE	0.050	0.050	0.050
1	CZM-4	CONVENTIONAL ZONE MODULE	0.055	0.750	0.750
TOTAL SUPERVISORY CURRENT			0.804		
TOTAL ALARM CURRENT			4.785		
NUMBER OF STANDBY HOURS REQUIRED			24		
TOTAL A.H. FOR STANDBY (TOTAL SUPERVISORY CURRENT x STANDBY HOURS)			19.296		
LENGTH OF ALARM OPERATION IN HOURS			.083		
TOTAL A.H. FOR ALARM OPERATION (TOTAL ALARM CURRENT x ALARM HOURS)			0.397		
TOTAL A.H. FOR SUPERVISORY AND ALARM OPERATION (SUPV AH + ALARM AH)			19.336		
TOTAL AH x BATTERY DERATING FACTOR 1.2			23.203		
TOTAL AH x BATTERY SAFETY FACTOR 20%			27.843		

**BATTERIES REQUIRED ARE 28 AH (OR LARGER)**

MODULES THAT DO NOT DRAW CURRENT: MON-2,MON-4,MPS-6,MPS-12,MMW-1,OMW-1,OMW-2,PLC-4,TBM-2

PANEL: NETWORK PANEL  
 LOCATION: MECHANICAL PENTHOUSE

Qty	Part Number	Description	Supv Current	Alarm Current	Total Supv Alarm
1	PSR-1	NETWORK PANEL POWER SUPPLY	0.070	0.070	0.070
1	NET-4	LOCAL NETWORK MODULE	0.005	0.005	0.005
1	CSN-4	SIGNAL MODULE	0.010	3.034	3.034
2	AD-2I	ADDRESSABLE DEVICE MODULE	0.175	0.175	0.350
1	NIM-1W	GLOBAL NETWORK MODULE	0.070	0.070	0.070
1	OCC-1	OUTPUT CONTROL MODULE	0.017	0.017	0.017
1	ASC-1	AMPLIFIER SUPERVISORY MODULE	0.022	0.041	0.022
1	ZCI-8B	OUTPUT MODULE	0.019	0.170	0.170
1	D2300CP	FIBER DRIVER MODULE	0.050	0.050	0.050
1	EL410D	AMPLIFIER	0.200	9.500	9.500
TOTAL SUPERVISORY CURRENT			0.813		
TOTAL ALARM CURRENT			13.307		
NUMBER OF STANDBY HOURS REQUIRED			24		
TOTAL A.H. FOR STANDBY (TOTAL SUPERVISORY CURRENT x STANDBY HOURS)			19.512		
LENGTH OF ALARM OPERATION IN HOURS			.083		
TOTAL A.H. FOR ALARM OPERATION (TOTAL ALARM CURRENT x ALARM HOURS)			1.104		
TOTAL A.H. FOR SUPERVISORY AND ALARM OPERATION (SUPV AH + ALARM AH)			20.616		
TOTAL AH x BATTERY DERATING FACTOR 1.2			24.739		
TOTAL AH x BATTERY SAFETY FACTOR 20%			29.687		

**BATTERIES REQUIRED ARE 30 AH (OR LARGER)**

MODULES THAT DO NOT DRAW CURRENT: MON-2,MON-4,MPS-6,MPS-12,MMW-1,OMW-1,OMW-2,PLC-4,TBM-2

PANEL: PAD-3 SIGNAL PANEL

Qty	Part Number	Description	Total Supv Alarm
1	PAD-3	SIGNAL PANEL	6.140*
TOTAL SUPERVISORY CURRENT			0.035
TOTAL ALARM CURRENT			6.140
NUMBER OF STANDBY HOURS REQUIRED			24
TOTAL A.H. FOR STANDBY (TOTAL SUPERVISORY CURRENT x STANDBY HOURS)			0.84
LENGTH OF ALARM OPERATION IN HOURS			.083
TOTAL A.H. FOR ALARM OPERATION (TOTAL ALARM CURRENT x ALARM HOURS)			0.509
TOTAL A.H. FOR SUPERVISORY AND ALARM OPERATION (SUPV AH + ALARM AH)			1.349
TOTAL AH x BATTERY DERATING FACTOR 1.2			1.619
TOTAL AH x BATTERY SAFETY FACTOR 20%			1.943

**BATTERIES REQUIRED ARE 2 AH (OR LARGER)**

\* CALCULATED FOR MAXIMUM LOAD.

THESE DRAWINGS ARE PREPARED PER PLANS AND SPECIFICATIONS FOR THIS PROJECT. THEY HAVE NOT BEEN REVIEWED FOR STATE AND LOCAL CODE COMPLIANCE.

PROJECT: HARRISBURG AREA COMMUNITY COLLEGE MUMMA HALL-WILDWOOD CONF CTR HARRISBURG PA

DRAWING NUMBER: FA19.202

TITLE: PAD-3 SIGNAL PANELS AND BATTERY CALCULATIONS

Berkshire Systems Group, Inc.  
 Corporate Office: 60 South Museum Road, Reading, PA 19607  
 Telephone: 610 775-1200  
 Fax: 610-775-9646  
 www.berkshiresystems.com

FOR THE USE OF PRODUCTS SUPPLIED BY BERKSHIRE SYSTEMS GROUP INC. ANY OTHER USE, MODIFICATION OR REPRODUCTION OF THIS PRINT IS PROHIBITED WITHOUT WRITTEN CONSENT OF BERKSHIRE SYSTEMS GROUP INC. A FEE WILL BE CHARGED FOR OTHER USE OR REPRODUCTION OF THIS PRINT.



DRAWING FILE: MUMMA HALL-WILDWOOD CONFERENCE CTR

ID.	DATE:	REVISIONS:	ID.	DATE:	REVISIONS:
DHS10/13/11	1/24/2011	DRAWINGS OF RECORD			

SCALE: 1/8" = 1' - 0"

DATE: 1/24/2011

JOB NUMBER: DPO2795

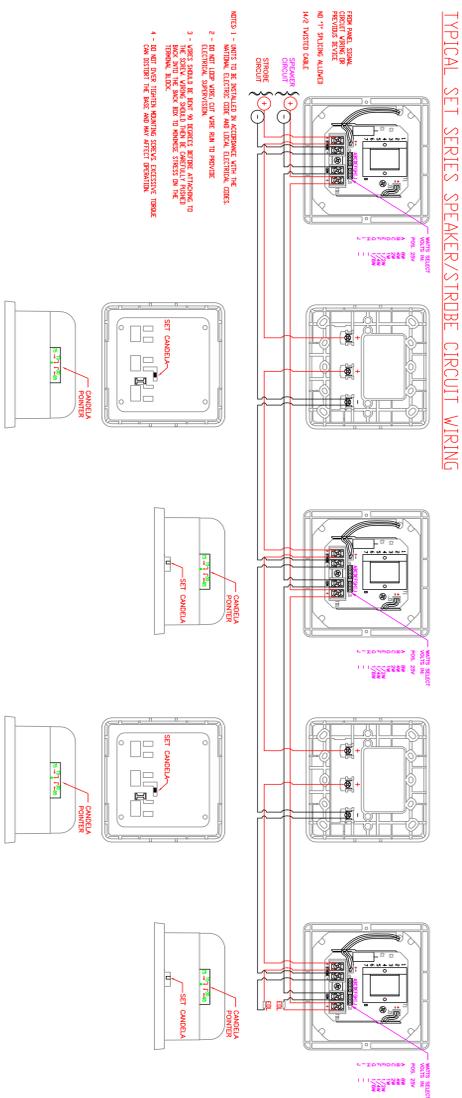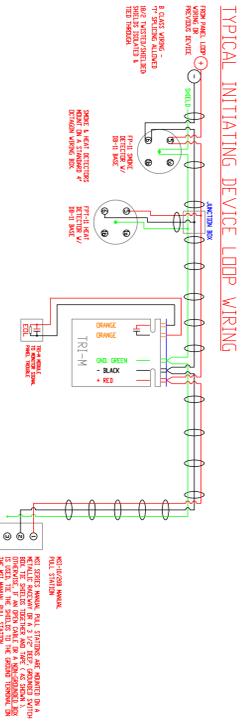

VOLTAGE DROP CALCULATION STROBE CIRCUITS

NOTIFICATION APPLIANCE CIRCUIT	NOTIFICATION APPLIANCE CURRENT	MAXIMUM CURRENT	PERCENT AVAILABLE SPARE CAPACITY (14AWG)	MAXIMUM LENGTH	SUPPLY VOLTAGE (14AWG)	ESTIMATED CIRCUIT LENGTH	VOLTAGE DROP	CALCULATED VOLTAGE AT END OF CIRCUIT	MINIMUM VOLTAGE ALLOWED
SC1	.708	1.5	53	954'	24	133'	0.58	23.42	16
SC2	.902	1.5	40	866'	24	201'	1.11	22.89	16
SC3	1.083	1.5	28	721'	24	299'	1.99	22.01	16
SC4	1.125	1.5	23	694'	24	223'	1.54	22.46	16
SC6	1.13	1.5	23	691'	24	293'	2.02	21.98	16
SC6	1.13	1.5	25	691'	24	272'	1.89	22.11	16
SC7	1.157	1.5	23	675'	24	348'	2.47	21.53	16
SC8	.53	1.5	65	1475'	24	128'	0.42	23.58	16
SC9	.858	1.5	43	911'	24	155'	0.82	23.18	16
SC10	.947	1.5	37	825'	24	231'	1.24	22.76	16
SC11	1.051	1.5	30	743'	24	286'	1.85	22.15	16
SC12	1.128	1.5	25	693'	24	225'	1.56	22.44	16
SC13	1.103	1.5	26	708'	24	251'	1.70	22.30	16
SC14	1.016	1.5	32	796'	24	276'	1.72	22.28	16

VOLTAGE DROP CALCULATION SPEAKER CIRCUITS

NOTIFICATION APPLIANCE CIRCUIT	NOTIFICATION APPLIANCE WATTAGE	MAXIMUM WATTAGE	PERCENT AVAILABLE SPARE CAPACITY (14AWG)	MAXIMUM LENGTH	SUPPLY VOLTAGE (14AWG)	ESTIMATED CIRCUIT LENGTH	VOLTAGE DROP	CALCULATED VOLTAGE AT END OF CIRCUIT	MINIMUM VOLTAGE ALLOWED
SP1	8.5	37.5	77	2233'	24	455'	0.98	23.02	16
SP2	9.375	37.5	75	2004'	24	498'	1.19	22.81	16
SP3	7.875	37.5	79	2368'	24	515'	1.04	22.96	16
SP4	1.5	37.5	96	13029'	24	128'	0.05	23.95	16
SP5	11.5	37.5	69	1628'	24	453'	1.34	22.66	16
SP6	12.5	37.5	67	1503'	24	596'	1.90	22.10	16
SP7	7.625	37.5	80	2443'	24	541'	1.06	22.94	16

AMPLIFIER SPARE CAPACITY

AMPLIFIER	NOTIFICATION APPLIANCE CIRCUITS	TOTAL WATTAGE	MAXIMUM WATTAGE	PERCENT AVAILABLE SPARE CAPACITY
1	SP1, SP2, SP3, SP4, SP5, SP6, SP7	58,875	100	41

THESE DRAWINGS ARE PREPARED PER PLANS AND SPECIFICATIONS FOR THIS PROJECT. THEY HAVE NOT BEEN REVIEWED FOR STATE AND LOCAL CODE COMPLIANCE.

PROJECT: HARRISBURG AREA COMMUNITY COLLEGE MUMMA HALL-WILDWOOD CONF CTR HARRISBURG PA

DRAWING NUMBER: FA19.203

TITLE: TYPICALS AND VOLTAGE DROP CALCULATIONS

**Berkshire Systems Group, Inc.**  
 Corporate Office: 60 South Museum Road, Reading, PA 19607  
 Telephone: 610-775-1200, Fax: 610-775-9648, www.berkshiresystems.com

FOR THE USE OF PRODUCTS SUPPLIED BY BERKSHIRE SYSTEMS GROUP INC. ANY OTHER USE, MODIFICATION OR REPRODUCTION OF THIS PRINT IS PROHIBITED WITHOUT WRITTEN CONSENT OF BERKSHIRE SYSTEMS GROUP INC. A FEE WILL BE CHARGED FOR OTHER USE OR REPRODUCTION OF THIS PRINT.

DRAWING FILE: MUMMA HALL-WILDWOOD CONFERENCE CTR

ID.	DATE:	REVISIONS:	ID.	DATE:	REVISIONS:
DHS	10/13/11	DRAWINGS OF RECORD			

SCALE: 1/8" = 1' - 0"

DATE: 1/24/2011

JOB NUMBER: DPO2795